

LAND CORNER RECORDATION CERTIFICATE
Filing Requirement of Act 74, Mich. P.A. 1970


For corners in

Table with columns: Marquette (County), Located In: (Town, Range, Section), Corner Code // (C-1, C-2, C-3). Rows include Public Land Survey, Property Controlling in Section, Miscellaneous Property in Sec., Lot No., and Private Claims.

Register of Deeds Stamp & File Number

I, Paul Bressette, in a field survey on June 1, 1994, do hereby certify that under requirements of P.A. 74, Michigan P.A. of 1970, the corner points mentioned in lines 1 and 2 above were in conformance with regulations and rules hereof as required in the current manual of survey instructions of the United States Department of the Interior, Bureau of Land Management or by a decree of a Court of Law and/or that the corner points mentioned in lines 3, 4 and 5 above were in conformance with the rules of the Michigan Board of Land Surveyors or by a Decree of a Court of Law; established, re-established, monumented, re-monumented, recovered, found as expressed below:

NOTE: Not more than 4 corners, all in the same town and range, may be recorded on this certificate.

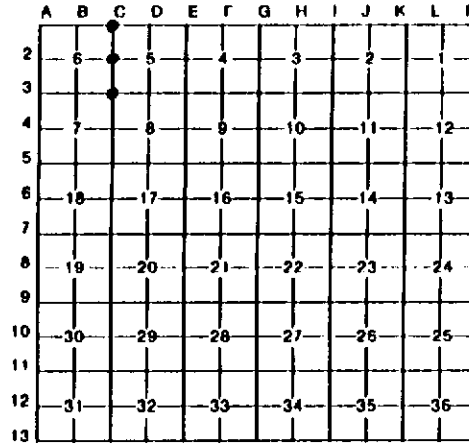

A. Description of original monument and accessories and/or subsequent restoration:

- C-1 Section corner common to Sections 5, 6, 31 and 32. 1952: Michigan Dept. of Conservation (DNR) set 1" iron pipe with brass cup witnessed by: 5" aspen S84W 48 links; 6" J.Pine N50E 164 links.
C-2 Quarter corner common to Sections 5 and 6. 1852: Martin M. Hall, D.S., set wood post witnessed by Cedar 12 N32W 16 links; Cedar 10 S22E 15 links.
C-3 Section corner common to Sections 5, 6, 7 and 8. 1952: Michigan Dept. of Conservation (DNR) set 1" iron pipe with brass cap witnessed by: 5" spruce S58W 112 links; 9" Cedar N10E 148 links


B. Description of corner evidence found and/or method applied in restoring or reestablishing corner:

- C-1 Found monument as described, both witnesses missing. Re-witnessed monument as found. Corner falls on east edge of power line right-of-way. Power pole witness is number 285.
C-2 No evidence of original survey or restoration found. Corner position re-established by single proportion between the Northwest and Southwest corners of Section 5. Measured 398 feet north to toe of slope (GLO-376 feet). Corner falls in old beaver pond and on the east edge of powerline clearing.
C-3 Found monument and the cedar NBT as described. Cedar is now behind several trees. Rewitnessed monument as found. Monument falls on east edge of powerline right-of-way.

C. Description of monument for corner and accessories established to perpetuate locating the position of the corner:

Table with 3 columns: C-1, C-2, C-3. Each column lists monument types (e.g., 1" iron pipe with brass cap) and associated measurements (e.g., 9" Red Pine N14°E 70.4').

w/DNR reference tag

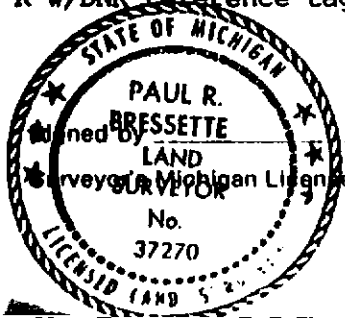

Signature of Paul R. Bressette and Date field.