

✓

MICHIGAN  
DEPARTMENT OF CONSERVATION  
FORESTRY DIVISION

LAND CORNER RECORD

T. 44 NR. 24 W.

Marquette

COUNTY

DESCRIPTION OF CORNER North 1/8 corner between Sec.'s 2-3


DESCRIPTION OF CORNER MONUMENT 3/8" x 32" iron pipe

WITNESSES TO CORNER 14" Hemlock S 34° E 12 links

7" Hard Maple N 56° W 24 links

"BT"

"BT"

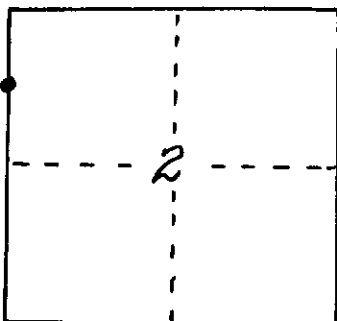

DESCRIPTION IN DETAIL AS TO HOW CORNER WAS LOCATED AND IDENTIFIED OR RESTORED.

1/8 corner placed by proportionate measure and on line between section corner to north and 1/4 corner to south.

SURVEYORS SEAL

SIGNED Billy D. Buckles DATE 11/12/57  
REGISTERED LAND SURVEYOR