LAND CORNER RECORDATION CERTIFICATE
Filing Requirement of Act 74, Mich. P.A. 1970

For corners in
Marquette
(County)

	Located In:	Corner Code ##
1. Public Land Survey	T 44N R 24W	I-5.
	T ___ R ___	
	T ___ R ___	
	T ___ R ___	
2. Property Controlling	S 14 T 44N R 24W	3.
in Section	S ___ T ___ R ___	
3. Miscellaneous	S ___ T ___ R ___	
Property in Sec.	S ___ T ___ R ___	

Register of Deeds Stamp & File Number

4. Lot No. _____ , Recorded Plat _____
5. Private Claims _____

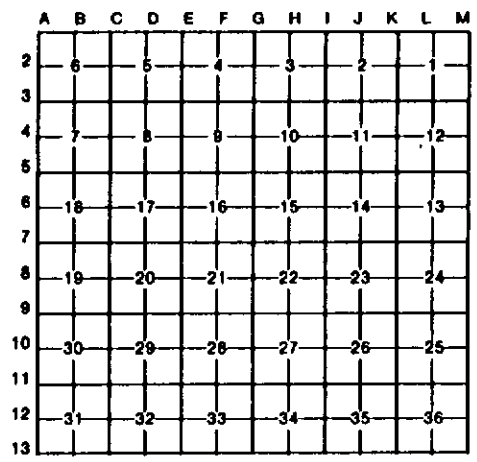

I, Dave Babbitt, in a field survey on 10/4, 19 89, do hereby certify that under requirements of P.A. 74, Michigan P.A. of 1970, the corner points mentioned in lines 1 and 2 above were in conformance with regulations and rules therefore as required in the current manual of survey instructions of the United States Department of the Interior, Bureau of Land Management or by a decree of a Court of Law and/or that the corner points mentioned in lines 3, 4 and 5 above were in conformance with the rules of the Michigan Board of Land Surveyors or by a Decree of a Court of Law; established, re-established, monumented, re-monumented, recovered, found as expressed below:

NOTE: Not more than 4 corners, all in the same town and range, may be recorded on this certificate.

A. Description of original monument and accessories and/or subsequent restoration:

I-5. NW section corner of Section 14. Marquette Co. Rd. Commission, 1948. "Old B.T. hemlock 10" N51W, 25 lks. scribe marks fair, cedar BT is decayed stump, new BT's and iron pipe. Cedar 8" S50E, 15.9', Cedar 5", S46W, 17.1'.

MDOT - date unknown. 1" iron pipe, 4" balsam, N30E, 13.97'
10" cedar, S50E, 16.14'
10" balsam, S67W, 18.51'

3. North 1/16 corner on the West section line of Section 14. No previous record.

B. Description of corner evidence found and/or method applied in restoring or reestablishing corner:

I-5. Found 3/4" pipe with both Marquette Co. Rd. Comm. witnesses in place but with blazes deteriorating. MDOT witnesses are also present but the two balsam are both dead and the cedar SE is the same tree as the MCRC S.E. witness. Re-witnessed pipe as found and set new cedar guard post.

3. Set MPOL between the West 1/4 corner and the NW section corner of Section 14.

C. Description of monument for corner and accessories established to perpetuate locating the position of the corner:

I-5. 3/4" pipe.
7" cedar, S63W, 12.0'
6" cedar, N39W, 3.7'
6" cedar, N10E, 32.6'
7" cedar, S37E, 24.6'

3. DNR Monument.
8" cedar, N47E, 14.1'
7" cedar, S82E, 32.3'
7" black spruce, S61W, 19.0'
5" cedar, N61W, 34.0'

Signed by David B. Babbitt Date 11-28-89
Surveyor's Michigan License No. 21558

FORM APPROVED BY MICHIGAN STATE BOARD OF LAND SURVEYORS, JAN. 28, 1971
REVISED MAY 14, 1975
REVISED JAN., 1983