

1993

COMMISSION

JOB NUMBER: 93300
SHEET NO. : 1-424

LAND CORNER RECORDATION CERTIFICATE
Filing Requirement of Act 74, Mich. P.A. 1970

For corners in

MARQUETTE
(County)

Located In:

Corner Code #

1. Public Land Survey	T	45N	R	24W	B-13
	T	44N	R	24W	B-1 ✓
2. Property Controlling in Section	T		R		
	S		T	R	
	S		T	R	
	S		T	R	
3. Miscellaneous Property in Sec.	S		T	R	
	S		T	R	

LIBER

1 PAGE 88

Register of Deeds Stamp & File Number

RECEIVED FOR INFO
MARQUETTE COUNTY
MICHIGAN
1993 DEC 30 PM 1:07

4. Lot No. _____, Recorded Plat _____
5. Private Claims _____

I, GERALD W. CARLSON, in a field survey on Friday, December 24, 1993, do hereby certify that under requirements of P.A. 74, Michigan P.A. of 1970, the corner points mentioned in lines 1 and 2 above were in conformance with regulations and rules therefore as required in the current manual of survey instructions of the United States Department of the Interior, Bureau of Land Management or by a decree of a Court of Law and/or that the corner points mentioned in lines 3, 4 and 5 above were in conformance with the rules of the Michigan Board of Land Surveyors or by a Decree of a Court of Law; established, re-established, monumented, re-monumented, recovered, found as expressed below:

	A	B	C	D	E	F	G	H	I	J	K	L	M
2	6		5		4		3		2				
3													
4	7		8		9		10		11		12		
5													
6	18		17		16		15		14		13		
7													
8	19		20		21		22		23		24		
9													
10	30		29		28		27		26		25		
11													
12	31		32		33		34		35		36		
13													

NOTE: Not more than 4 corners, all in the same town and range, may be recorded on this certificate.

A. Description of original monument and accessories and/or subsequent restoration:


B-13: Quarter Corner common to Section 31, T45N-R24W and 1918 - R.A. Brotherton's field notes indicate a bearing tree Section 6, T44N-R24W. 1841: William Burt's original survey Spruce stub. No corner accessories given. notes describe the corner monument as a wood post referenced by:
7" Tamarack N67E, 29 1
8" Spruce N43W, 12 1

B. Description of corner evidence found and/or method applied in restoring or reestablishing corner:

1993 - Measured in from the West along Jamros's cut line with a hip chain to area of corner. Found Jamros's pickett and his search area. Approximately 30 ft. West of Jamros's pickett we found a old Spruce stump with a butt blaze facing the proper direction for the Spruce BT and 3 very old blazes on Cedar trees facing the corner position as measured from the found Spruce stump. A temporary pickett was placed in this position (S43E, 7.92' from Spruce stump) and tied in by traverse. The distance to the Quarter Corner common to Section 36, T45N-R25W and Section 1, T44N-R25W was calculated to be within 9 ft. of G.L.O. from this pickett. A lengthy discussion at the peer group ensued with the consensus being that these old Cedar trees were blazed by the cruisers who found a BT Spruce stub in place and it was decided that this was sufficient evidence to monument the corner. Peer group ratification 12-20-93.

C. Description of monument for corner and accessories established to perpetuate locating the position of the corner:

1993 - Set a 8.0 ft. long 3/4" diameter iron rebar with a 3 1/4" diameter aluminum tablet Marquette County Survey Monument stamped to identify the corner referenced by nails in:
5" Cedar N60E 16.25 ft.
5" Cedar S28E 41.48 ft.
6" Cedar S88W 16.94 ft.
4" Cedar N49W 19.39 ft.
Bk. 6, Pg. 14

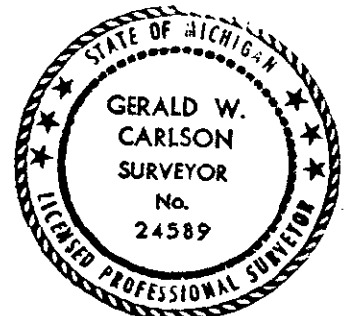

Signed by Gerald W. Carlson Date 12-29-93

Surveyor's Michigan License No. 24589