MARQUETTE COUNTY REMONUMENTATION

CORNER RATIFICATION FORM

LOCATION

T. 44 N., R. 25 W.

SURVEY &
REMONUMENTATION
MAR 1 5 1999
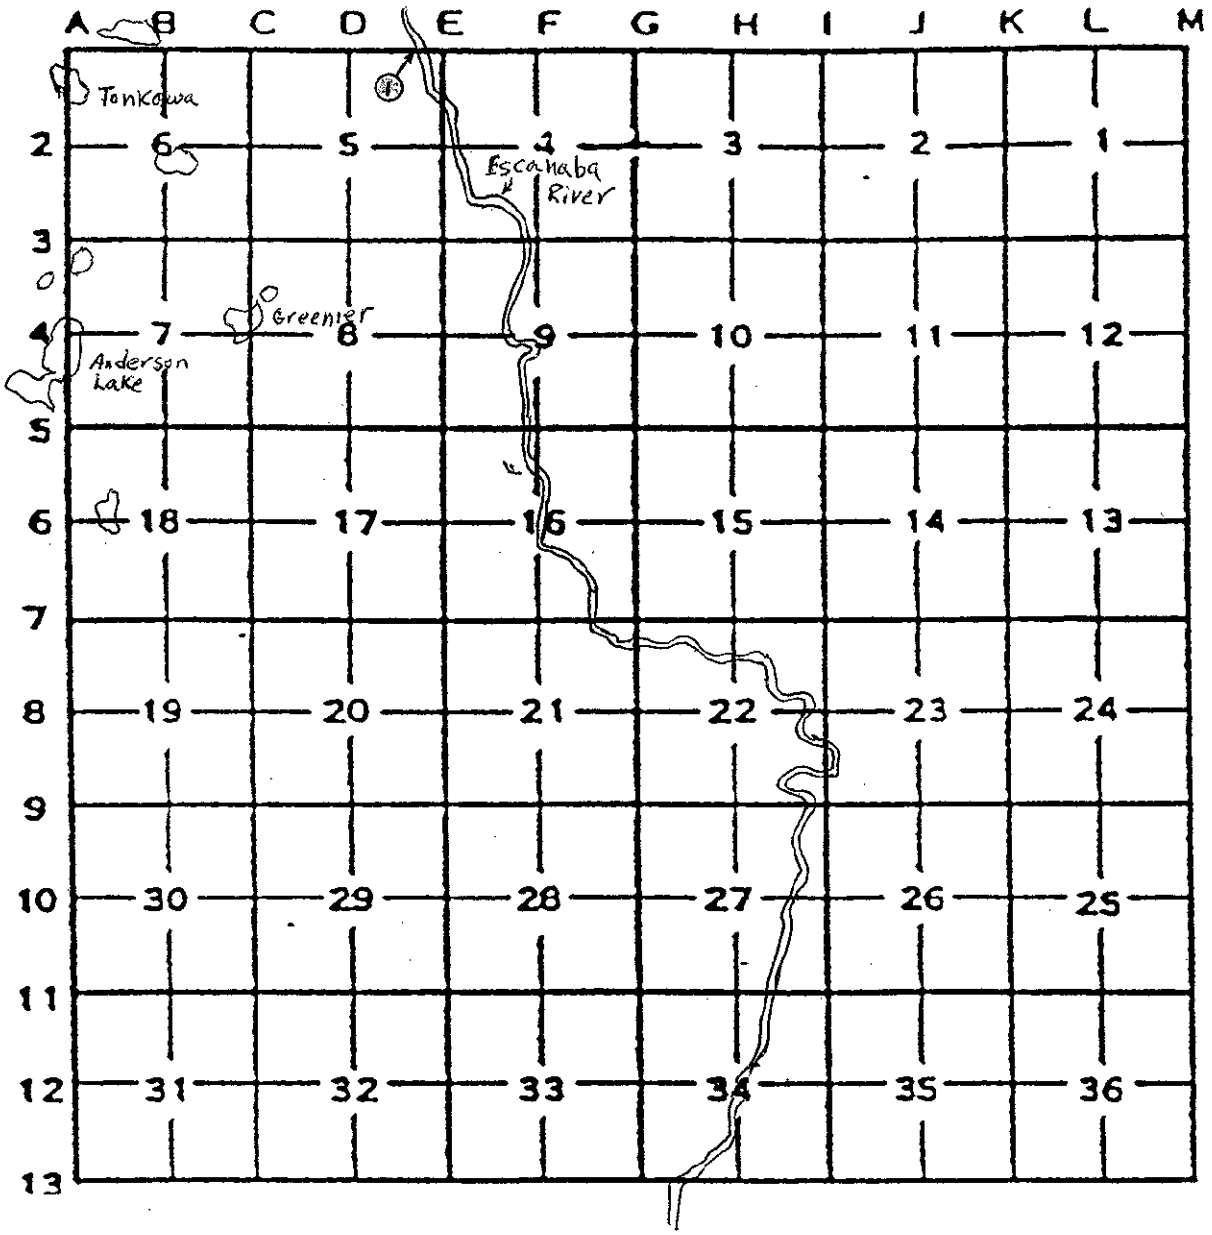
SECTION