

LAND CORNER RECORDATION CERTIFICATE
Filing Requirement of Act 74, Mich. P.A. 1970

For corners in

Table with columns: (County) Marguette, Located In: T 45N R 24W, Corner Code // G-5, H-5. Rows include Public Land Survey, Property Controlling in Section, and Miscellaneous Property in Sec.

Register of Deeds Stamp & File Number

- 4. Lot No. , Recorded Plat
5. Private Claims

Grid table with columns A-M and rows 2-13. Contains numerical data and two black dots at grid intersections.

I, Paul Bressette, in a field survey on July 12, 1994, do hereby certify that under requirements of P.A. 74, Michigan P.A. of 1970, the corner points mentioned in lines 1 and 2 above were in conformance with regulations and rules therefore as required in the current manual of survey instructions of the United States Department of the Interior, Bureau of Land Management or by a decree of a Court of Law and/or that the corner points mentioned in lines 3, 4 and 5 above were in conformance with the rules of the Michigan Board of Land Surveyors or by a Decree of a Court of Law; established, re-established, monumented, re-monumented, recovered, found as expressed below:

NOTE: Not more than 4 corners, all in the same town and range, may be recorded on this certificate.

A. Description of original monument and accessories and/or subsequent restoration:


- G-5 Section Corner common to Sections 9, 10, 15 and 16. 1905: Charles Cummings, County Surveyor. Reset corner from bearing trees. No witnesses listed.
H-5 Quarter Corner common to Sections 10 and 15. Found 5/8 inch iron pin at intersection of fences north, south, and west, and remains of fence east. No prior record.

B. Description of corner evidence found and/or method applied in restoring or reestablishing corner:

- G-5 No evidence of original bearing trees or Cummings restoration found. Local resident claims corner was by old birch tree at fence intersection, but tree and fence intersection is gone. He put up new fence, but said it is not on the line. Found evidence of old fence east and south. Corner position re-established by double-proportion from corners one-half mile north, south, east, and west. Corner lines up with old fences fairly well, and fits GLO calls north, east and west.
H-5 Corner position re-established at found iron pin. Measured west 510 feet along old fenceline to apparent edge of old beaver pond (GLO - 495 feet), and east 1,386 feet along old fenceline to top of knob (GLO - 1,386 feet). Drove DNR monument over iron pin and witnessed.

C. Description of monument for corner and accessories established to perpetuate locating the position of the corner:

Table with columns: G-5 DNR Monument, H-5 DNR Monument. Lists monument types and measurements like 6" Maple N55E 13.8', 5" Tamarack S32E 81.25', etc.

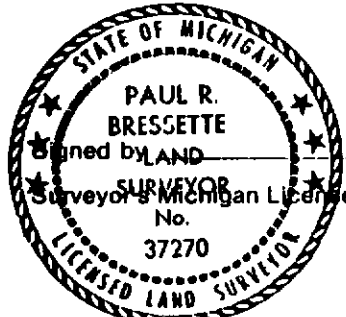

Paul R. Bressette Date
37270