


LAND CORNER RECORDATION CERTIFICATE
Filing Requirement of Act 74, Mich. P.A. 1970

For corners in

Table with columns: Marquette (County), Located In, Corner Code //
1. Public Land Survey T 45N R 24W G-1, G-2
2. Property Controlling in Section S 03 T 45N R 24W 3, 10
3. Miscellaneous Property in Sec. S T R

Register of Deeds Stamp & File Number

- 4. Lot No. , Recorded Plat
5. Private Claims

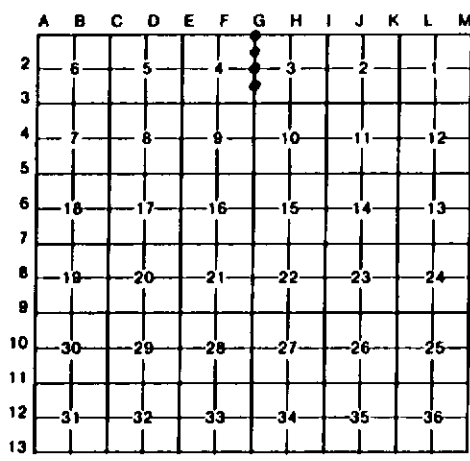

I, Paul Bressette, in a field survey on July 28, 1994, do hereby certify that under requirements of P.A. 74, Michigan P.A. of 1970, the corner points mentioned in lines 1 and 2 above were in conformance with regulations and rules therefore as required in the current manual of survey instructions of the United States Department of the Interior, Bureau of Land Management or by a decree of a Court of Law and/or that the corner points mentioned in lines 3, 4 and 5 above were in conformance with the rules of the Michigan Board of Land Surveyors or by a Decree of a Court of Law; established, re-established, monumented, re-monumented, recovered, found as expressed below:

NOTE: Not more than 4 corners, all in the same town and range, may be recorded on this certificate.

A. Description of original monument and accessories and/or subsequent restoration:

- G-1 Section Corner common to Sections 3, 4, 33 and 34. 1978: Charles F. Clark, RLS. Set 1/2" x 18" rebar witnessed by: 5" Maple N30W 14.47'; 3" Maple N15E 9.29'; 6" Maple S20E 14.60'.
G-2 Quarter Corner common to Sections 3 and 4. 1852: A.D. Sullivan, D.S. Set wood post witnessed by: Spruce 12" S85W 23 links; Spruce 9" S56E 7 links.
3 North One-sixteenth Corner common to Sections 3 and 4. Not set in original survey, no evidence of subsequent establishment.
10 South One-sixteenth Corner common to Sections 3 and 4. Not set in original survey, no evidence of subsequent establishment.

B. Description of corner evidence found and/or method applied in restoring or reestablishing corner:

- G-1 Found rebar and two witnesses as described. Replaced rebar with DNR monument and witnessed. Reblazed witnesses with face and butt blazes, distances are measured to notch in butt blaze.
G-2 No evidence of original survey or restoration found. Corner position re-established by single proportion between the Northwest and Southwest corners of Section 3. Measurement north to stream fits GLO very well (measured 41 feet, GLO 39.6 feet).
3 Corner position established by single proportion between the Northwest and West Quarter corners of Section 3.
10 Corner position established mid-point and on-line between the Southwest and West Quarter corners of Section 3. Due to a calculation error, four defaced witnesses are east of corner: 12" Sugar N75E; 16" Sugar N79E; 14" Sugar S79E; and 7" Sugar S68E from true corner. 12" and 7" Sugars have blazes facing away from corner.

C. Description of monument for corner and accessories established to perpetuate locating the position of the corner:

Table with columns: G-1 DNR monument, G-2 DNR monument, 3 DNR monument, 10 DNR monument
5"Sugar N23E 8.95', 6"Cedar N72E 19.7', 6"Cherry N33E 26.0', 13"R.Maple N49E 15.9'
17"Sugar S07W 13.2', 7"Cedar S04E 37.15', 8"Cherry S76E 32.0', 8"Sugar S41E 28.1'
9"Sugar S29W 14.2', 8"Cedar S15W 32.55', 4"Sugar S26W 17.7', 7"Sugar S18W 24.7'
8"Sugar N40W 14.45', 6"Cedar S44W 44.35', 10"Sugar N47W 46.3', 8"Sugar N39W 30.65'



Paul R. Bressette Date
37270