

JOB NUMBER: 93300
 SHEET NO. : 1-380
 For corners in


LAND CORNER RECORDATION CERTIFICATE
Filing Requirement of Act 74, Mich. P.A. 1970

 MARQUETTE
 (County)

Located In:

Corner Code #

1. Public Land Survey

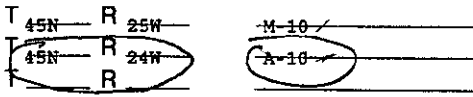

2. Property Controlling in Section

S _____ T _____ R _____

3. Miscellaneous Property in Sec.

S _____ T _____ R _____

4. Lot No. _____, Recorded Plat _____
 5. Private Claims _____

MARQUETTE COUNTY
 RECEIVED FOR RECORD
 1993 DEC 29 AM 10:35
 REGISTER OF DEEDS
 LIBER 1 PAGE 29
 Register of Deeds Stamp & File Number

I, GERALD W. CARLSON, in a field survey on Thursday, December 23, 1993, do hereby certify that under requirements of P.A. 74, Michigan P.A. of 1970, the corner points mentioned in lines 1 and 2 above were in conformance with regulations and rules therefore as required in the current manual of survey instructions of the United States Department of the Interior, Bureau of Land Management or by a decree of a Court of Law and/or that the corner points mentioned in lines 3, 4 and 5 above were in conformance with the rules of the Michigan Board of Land Surveyors or by a Decree of a Court of Law; established, re-established, monumented, re-monumented, recovered, found as expressed below:

	A	B	C	D	E	F	G	H	I	J	K	L	N
2	6		5		4		3		2		1		
3													
4	7		8		9		10		11		12		
5													
6	18		17		16		15		14		13		
7													
8	19		20		21		22		23		24		
9													
10	30		29		28		27		26		25		
11													
12	31		32		33		34		35		36		
13													

NOTE: Not more than 4 corners, all in the same town and range, may be recorded on this certificate.

A. Description of original monument and accessories and/or subsequent restoration:

M-10: Quarter Corner common to Section 25, T45N-R25W and Section 30, T45N-R24W. 1844: William A. Burt's original survey notes describe the corner monument as a wood post referenced by:
 12" W.Pine S48E, 14 l
 12" W.Pine S58W, 10 l
 1939 - a map of government Lot 1 Section 30, by R.A. Brotherton indicates a 3" iron pipe at this corner position. No corner accessories were given.
 (See reverse side)

B. Description of corner evidence found and/or method applied in restoring or reestablishing corner:

1993 - Found 3/8 iron pin. Replaced with Marquette County Survey Monument. Peer group ratification 12-20-93.

SURVEY &
 REMONUMENTATION


JAN 11 1999

SECTION

RATIFIED BY PEER GROUP
 P.A. 345 OF 1990
Larry J. Busam
 DATE Dec. 20, 1993

C. Description of monument for corner and accessories established to perpetuate locating the position of the corner:

1993 - Replaced existing marker with a 2 1/8" diameter aluminum pipe capped with a 3 1/4" diameter aluminum tablet Marquette County Survey Monument stamped to identify the corner referenced by nails in:
 6" Spruce N19W 17.22 ft. Clark NBT
 7" Norway Pine N51E 15.03 ft. Clark NBT
 8" Norway Pine S27E 8.68 ft. Clark NBT
 8" Spruce S23W 20.31 ft. Clark NBT
 0.35 ft. above ground. East/West fence line 120 ft. +/- West lines up with corner.
 Bk. 6, Pg. 4

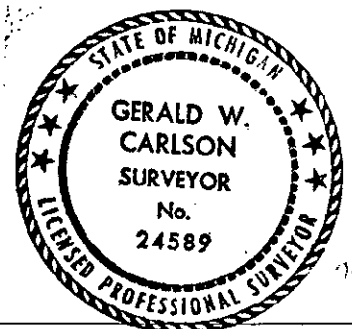

Signed by Gerald W. Carlson

Date 12-28-93

Surveyor's Michigan License No. 24589

Record No. 380

AK 2971
1.66
0016
11/16/99

Part "A" Continued:

1967 - MCRC field book # 802 (page 9) indicates a 1" iron pipe at the East 1/4 corner of Section 25, T45N-R25W

1985 - C.F. Clark found a 3/8 iron rod (RLS No. 6844 ?) with 3" pipe lying next to it. Referenced by found nail in:

5" Spruce	N20W	17.21 ft.	L5 RC, PG 56
4" Norway Pine	N51E	15.06 ft.	
7" Norway Pine	S26E	8.70 ft.	
7" Spruce	S21W	20.30 ft.	

SURVEY &
REMONUMENTATION

JAN 11 1999

SECTION

