

1987

CORALISANTU

OB NUMBER: 93300  
HEET NO. : 1-382  
For corners in

**LAND CORNER RECORDATION CERTIFICATE**  
Filing Requirement of Act 74, Mich. P.A. 1970

<u>MARQUETTE</u> (County)	Located in:	Corner Code #
1. Public Land Survey	T45N R25W	M-12
	T45N R24W	A-12 ✓
	T _____ R _____	_____
	T _____ R _____	_____
2. Property Controlling in Section	S _____ T _____ R _____	_____
	S _____ T _____ R _____	_____
3. Miscellaneous Property in Sec.	S _____ T _____ R _____	_____
	S _____ T _____ R _____	_____

MARQUETTE COUNTY  
MICHIGAN  
RECEIVED FOR RECORDING

1983 DEC 29 AM 10:35

*William A. Brotherton*  
REGISTER OF DEEDS

**1 PAGE 30**

Register of Deeds Stamp & File Number

4. Lot No. \_\_\_\_\_, Recorded Plat \_\_\_\_\_

5. Private Claims \_\_\_\_\_

I, GERALD W. CARLSON, in a field survey on Saturday, December 18, 1983, do hereby certify that under requirements of P.A. 74, Michigan P.A. of 1970, the corner points mentioned in lines 1 and 2 above were in conformance with regulations and rules therefore as required in the current manual of survey instructions of the United States Department of the Interior, Bureau of Land Management or by a decree of a Court of Law and/or that the corner points mentioned in lines 3, 4 and 5 above were in conformance with the rules of the Michigan Board of Land Surveyors or by a Decree of a Court of Law; established, re-established, monumented, re-monumented, recovered, found as expressed below:

A	B	C	D	E	F	G	H	I	J	K	L	M
2	6	5	4	3	2	1						
3												
4	7	8	9	10	11	12						
5												
6	18	17	16	15	14	13						
7												
8	19	20	21	22	23	24						
9												
10	30	29	28	27	26	25						
11												
12	31	32	33	34	35	36						
13												

**NOTE: Not more than 4 corners, all in the same town and range, may be recorded on this certificate.**

**A. Description of original monument and accessories and/or subsequent restoration:**

M-12: Quarter Corner common to Section 36, T45N-R25W and Section 31, T45N-R24W. 1844: William A. Burt's original survey notes describe the corner monument as a wood post referenced by:	1918 - Iron and BT indicated on old field notes of R.A. Brotherton.
10" Tamarack S40W, 41 l	1954 - R.J. Brotherton survey indicated an old iron - no BT's visible referenced by:
8" Tamarack N66E, 20 l	20" White Pine N54.5E 33 l (21.78')
	13" White Pine N381/4W 61 l (40.26')
	(See reverse side for additional information)

**B. Description of corner evidence found and/or method applied in restoring or reestablishing corner:**

1993 - Found 1/2" rerod with a Benson Forest I.D. cap and PS # 25849. Replaced 1/2" rerod with Marquette County Survey Monument. Distance North corresponds to Benson Forest and Brotherton surveys.  
Peer group ratification 12-13-93.


**C. Description of monument for corner and accessories established to perpetuate locating the position of the corner:**

1993 - Replaced 1/2" rerod with Benson Forest I.D. cap PS # 25849 with a 2 1/8" diameter aluminum pipe capped with a 3 1/4" diameter aluminum tablet Marquette County Survey Monument stamped to identify the corner referenced by nails in:

14" White Pine	N07E	67.15 ft.	Jamros NBT
8" White Pine	S31E	27.38 ft.	Jamros NBT
10" White Pine	S47W	31.65 ft.	Jamros NBT
13" White Pine	N39W	40.58 ft.	Brotherton & Jamros NBT

Monument is 0.35 ft. above ground with carsonite witness post nearby.  
Center line two track road N45W 21 ft.+/- . Corner is near an abandoned mobile home. Bk. 4, Pg. 36.

Signed by Gerald W. Carlson Date 12-28-93  
Surveyor's Michigan License No. 24589

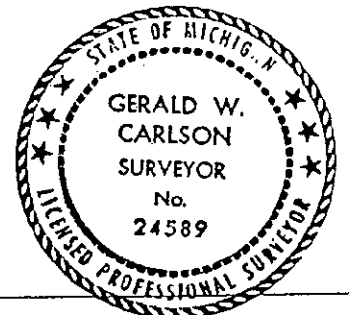

Record No. 382

Part "A" Continued:

1992 - R.L. Jamros found a 1" x 56" iron bar referenced by:

22" White Pine	N041/2E	67.50 ft.
10" White Pine	S35E	27.30 ft.
18" White Pine	N381/4W	40.26 ft. Brotherton NBT
12" White Pine	S45W	31.60 ft.

11/29/11  
1900  
11/29/11