

**SURVEY &
REMONUMENTATION**

DEC 16 1996

COMMISSION LAND CORNER RECORDATION CERTIFICATE
Filing Requirement of Act 74, Mich. P.A. 1970

JOB NUMBER: 93300
SHEET NO. : 1-376
For corners in

<u>MARQUETTE</u> (County)		Located In:	Corner Code ##
1. Public Land Survey	T <u>45N</u> R <u>24W</u>		<u>M-6</u> ✓
	T <u>45N</u> R <u>25W</u>		<u>A-6</u>
	T _____ R _____		_____
	T _____ R _____		_____
2. Property Controlling in Section	S _____ T _____ R _____		_____
	S _____ T _____ R _____		_____
3. Miscellaneous Property in Sec.	S _____ T _____ R _____		_____
	S _____ T _____ R _____		_____

LIBER 1 PAGE 90
Register of Deeds Stamp & File Number

RECEIVED FOR
MARQUETTE COUNTY
MICHIGAN
DEC 30 PM 1:07
1993

4. Lot No. _____, Recorded Plat _____
5. Private Claims _____

A	B	C	D	E	F	G	H	I	J	K	L	M
2	6	5	4	3	2	1						
3												
4	7	8	9	10	11	12						
5												
6	18	17	16	15	14	13						
7												
8	10	20	21	22	23	24						
9												
10	30	29	28	27	26	25						
11												
12	31	32	33	34	35	36						
13												

I, GERALD W. CARLSON, in a field survey on Monday, December 27, 1993, do hereby certify that under requirements of P.A. 74, Michigan P.A. of 1970, the corner points mentioned in lines 1 and 2 above were in conformance with regulations and rules therefore as required in the current manual of survey instructions of the United States Department of the Interior, Bureau of Land Management or by a decree of a Court of Law and/or that the corner points mentioned in lines 3, 4 and 5 above were in conformance with the rules of the Michigan Board of Land Surveyors or by a Decree of a Court of Law; established, re-established, monumented, re-monumented, recovered, found as expressed below:

NOTE: Not more than 4 corners, all in the same town and range, may be recorded on this certificate.

A. Description of original monument and accessories and/or subsequent restoration:

<p>M-6: Quarter Corner common to Section 13, T45N-R25W and Section 18, T45N-R24W. 1844: William A. Burt's original survey notes describe the corner monument as a wood post referenced by:</p> <p>4" Spruce Pine S25E, 28 l</p> <p>3" Spruce Pine S28W, 37 l</p>	<p>1942 - Gregory Shadko of MDNR indicates he set a corner at this position according to a survey of the Swanzy Lake fishing site. No corner accessories were given. His field notes indicate that he set this corner from the G.L.O. bearing trees</p> <p>4" Spruce Pine S25E, 28 l</p> <p>3" Spruce Pine S28W, 37 l</p> <p>His notes indicate that the SE spruce pine was a stub and the SW bearing tree was a stump. (See reverse side)</p>
--	--

B. Description of corner evidence found and/or method applied in restoring or reestablishing corner:

1993 - Found octagonal concrete monument Michigan Conservation Department fish site (1940). Distance South measures 2639.70, distance North measures 2638.07. Left concrete monument as found. Peer group ratification 12-13-93.

C. Description of monument for corner and accessories established to perpetuate locating the position of the corner:

1993 - Michigan Conservation Department octagonal concrete monument stamped to identify the corner referenced by nails in:

9" Jack Pine S35W 54.38 ft.

9" Jack Pine S82W 54.28 ft.


9" Jack Pine N04E 120.67 ft.

11" Jack Pine N73E 116.36 ft.

Monument is 1.1 ft. above ground, 15 ft. +/- East of high water mark of a pond.

Stamped MCR 1993 (Marquette County Remonumentation) on cap of the existing monument.

Bk. 6, Pg. 18

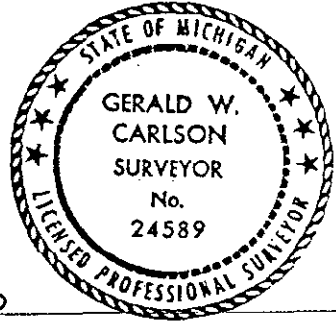

Signed by Gerald W. Carlson Date 12-29-93

Record No. 376

Part "A" Continued:

1942 - MCRC field book # 712 indicates a BT corner. Concrete monument set by Shadko. Spruce Pine BT S28E 28 1 is now a dry stub, markings very distinct set by William Burt in 1844. No corner accessories were given. Coordinates for this corner were indicated in the field book.

AP 900
A 100
V 100
W 100