

MARQUETTE COUNTY MICHIGAN RECEIVED FOR RECORD

1993 SEP 30 PM 4:39

Patricia R. Monney REGISTER OF DEEDS


LAND CORNER RECORDATION CERTIFICATE Filing Requirement of Act 74, Mich. P.A. 1970

For corners in Marquette (County) Located In: Corner Code // 1. Public Land Survey T 45N R 25W C-4, C-5 2. Property Controlling in Section S 8 T 45N R 25W 3, 10 3. Miscellaneous Property in Sec. S T R 4. Lot No. Recorded Plat 5. Private Claims

Liber 5 R.C. Page 388


Register of Deeds Stamp & File Number

I, Paul R. Bressette, in a field survey on August 19 93 do hereby certify that under requirements of P.A. 74, Michigan P.A. of 1970, the corner points mentioned in lines 1 and 2 above were in conformance with regulations and rules therefore as required in the current manual of survey instructions of the United States Department of the Interior, Bureau of Land Management or by a decree of a Court of Law and/or that the corner points mentioned in lines 3, 4 and 5 above were in conformance with the rules of the Michigan Board of Land Surveyors or by a Decree of a Court of Law; established, re-established, monumented, re-monumented, recovered, found as expressed below:

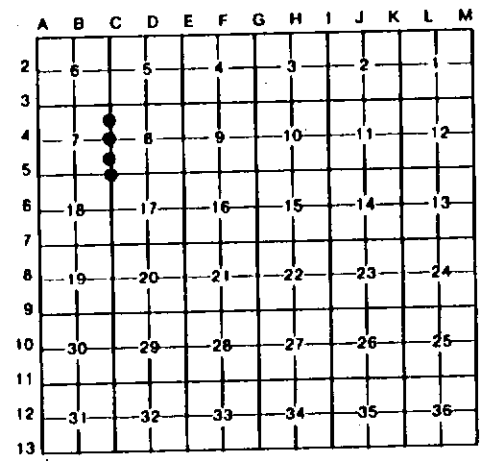

NOTE: Not more than 4 corners, all in the same town and range, may be recorded on this certificate.

- A. Description of original monument and accessories and/or subsequent restoration: C-4. Quarter corner common to Sections 7 and 8. 1852: Martin M. Hall, D.S. Set sugar post witnessed by Sugar 18 S84W 30 links; Hemlock 18 N78E 14 links. C-5. Section corner common to Sections 7,8,17 and 18. 1984: D. Babbitt, RLS. 1" iron pipe with 4" brass cap witnessed by: 11" Spruce N59E 90.2'; 5" W. Pine S20W 7.4'; 12" W. Pine N40W 18.1'; 6" W. Pine S35E 31.9'. 3. North One-sixteenth corner common to Sections 7 and 8. Not set in original survey, no evidence of subsequent establishment. 10. South One-sixteenth corner common to Sections 7 and 8. Not set in original survey, no evidence of subsequent establishment. B. Description of corner evidence found and/or method applied in restoring or reestablishing corner: C-4. No evidence of original survey or restoration found. Corner position re-established mid-point and on-line between the Northwest and Southwest corners of Section 8. This position fits a terrain call to leave swamp to the north very well. C-5. Found 1" iron pipe bent and with cap broken off. Witnesses were all cut during clearing of power line right of way. Found stumps of NW and SW NBT's with measuring notches and scribing and set new DNR monument. Corner falls within cleared right of way of power line. 3. Corner position established mid-point and on-line between the Northwest and West Quarter corners of Section 8. 10. Corner position established mid-point and on-line between the Southwest and West Quarter corners of Section 8. C. Description of monument for corner and accessories established to perpetuate locating the position of the corner: C-4. DNR monument 7" R.Maple N20E 18.35' 7" R.Maple S45E 17.2' 5" W.Pine S45W 42.9' 11" W.Pine N74W 25.6' C-5. DNR monument 7" R.Pine S10E 89.55' 5" W.Pine S55W 40.1' 5" R.Pine N60W 89.8' 12" W.Pine N40W 18.1'* 5" W.Pine S20W 7.4'* 3. DNR monument 6" Tamarack N73E 18.6' 4" B.Spruce S43E 20.0' 5" Tamarack S71W 6.1' 4" B.Spruce N38W 12.85' 10. DNR monument 11" W.Pine N73E 7.8' 11" W.Pine S71E 9.85' 9" W.Pine S24W 6.4' 7" W.Pine N48W 13.75' * stumps

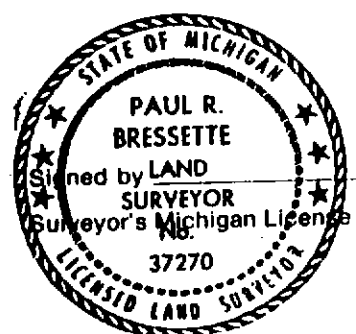

Paul R. Bressette Date 9-30-93

37270