

MARQUETTE COUNTY
MICHIGAN
RECEIVED FOR RECORD

1993 SEP 30 PM 4:39

LAND CORNER RECORDATION CERTIFICATE
Filing Requirement of Act 74, Mich. P.A. 1970

For corners in


Marquette (County)	Located In:	Corner Code //
1. Public Land Survey	T 45N R 25W	D-1, E-1
	T R	
	T R	
	T R	
2. Property Controlling in Section	S 5 T 45N R 25W	1, 2
	S T R	
3. Miscellaneous Property in Sec.	S T R	
	S T R	

Paul R. Bressette
REGISTER OF DEEDS

Liber 5 R.C. Page 385

Register of Deeds Stamp & File Number

- 4. Lot No. _____ Recorded Plat
- 5. Private Claims _____

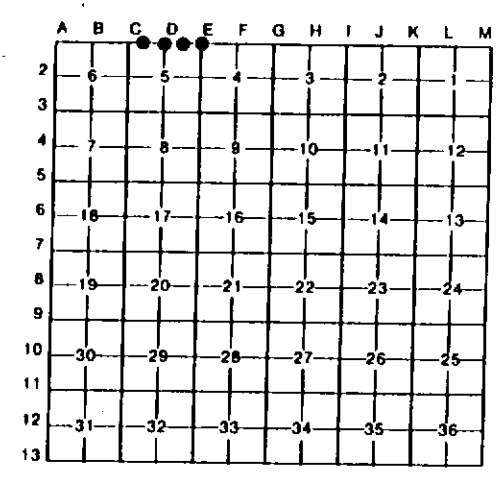

I, Paul R. Bressette, in a field survey on September-October, 19 92, do hereby certify that under requirements of P.A. 74, Michigan P.A. of 1970, the corner points mentioned in lines 1 and 2 above were in conformance with regulations and rules therefore as required in the current manual of survey instructions of the United States Department of the Interior, Bureau of Land Management or by a decree of a Court of Law and/or that the corner points mentioned in lines 3, 4 and 5 above were in conformance with the rules of the Michigan Board of Land Surveyors or by a Decree of a Court of Law; established, re-established, monumented, re-monumented, recovered, found as expressed below:

NOTE: Not more than 4 corners, all in the same town and range, may be recorded on this certificate.

A. Description of original monument and accessories and/or subsequent restoration:


- D-1. Quarter corner common to Sections 5 and 32. 1844: W.A. Burt, D.S. Set wood post witnessed by: Y.Birch 14 N81E 34 links; Y.Birch 22 N43W 14 links.
- E-1. Section corner common to Sections 4,5,32 and 33. 1942: Marquette County Road Commission. 1" iron pipe witnessed by: W.Pine 9 S15W 34.5'; W.Pine 8 N31W 8.9'.
 - 1. West One-sixteenth corner common to Sections 5 and 32. Not set in original survey, no evidence of subsequent establishment.
 - 2. East One-sixteenth corner common to Sections 5 and 32. Not set in original survey, no evidence of subsequent establishment.

B. Description of corner evidence found and/or method applied in restoring or reestablishing corner:

- D-1. No evidence of original survey or restoration found. Corner position re-established mid-point and on-line between the Northeast and Northwest corners of Section 5.
- E-1. Found 1" iron pipe and NBT's as described. Both NBT's dead but standing. Replaced iron pipe with DNR monument and witnessed.
 - 1. Corner position established mid-point and on-line between the Northwest and North Quarter corners of Section 5.
 - 2. Corner position established mid-point and on-line between the Northeast and North Quarter corners of Section 5. Corner falls about 40 feet east of the top of a rock knob.

C. Description of monument for corner and accessories established to perpetuate locating the position of the corner:

D-1. DNR monument	E-1. DNR monument	1. DNR monument	2. DNR monument
6" Sugar N32E 19.0'	16" R.Pine N44E 37.9'	5" W.Spruce N43E 21.2'	6" W.Spruce N43E 24.3'
6" W.Spruce S51E 53.4'	8" R.Pine S26E 39.0'	5" tw.R.Maple S42E 6.1'	4" R.Maple S24E 27.3'
6" Sugar S73W 27.9'	8" J.Pine S10W 26.7'	8" R.Maple S70W 12.7'	5" R.Maple S45W 22.25'
6" W.Spruce N16W 26.25'	10" W.Pine S54W 44.6'	8" W.Birch N58W 24.9'	6" W.Spruce N15W 17.1'

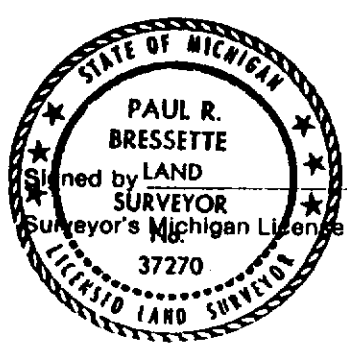

Paul R. Bressette Date 9-30-93

Surveyor's Michigan License No. 37270