

MARQUETTE COUNTY  
MICHIGAN  
RECEIVED FOR RECORD  
1993 SEP 30 PM 4:39

LAND CORNER RECORDATION CERTIFICATE  
Filing Requirement of Act 74, Mich. P.A. 1970

*Patricia L. Monbey*  
REGISTER OF DEEDS

For corners in	Located In:	Corner Code //
Marquette (County)		
1. Public Land Survey	T 45N R 25W	A-2, A-3
	T R	
	T R	
	T R	
2. Property Controlling in Section	S 6 T 45N R 25W	10
	S T R	
3. Miscellaneous Property in Sec.	S T R	
	S T R	
4. Lot No. _____, Recorded Plat		
5. Private Claims		

Liber 5 R.C. Page 383

Register of Deeds Stamp & File Number

I, Paul R. Bressette in a field survey on August, 19 93, do hereby certify that under requirements of P.A. 74, Michigan P.A. of 1970, the corner points mentioned in lines 1 and 2 above were in conformance with regulations and rules therefore as required in the current manual of survey instructions of the United States Department of the Interior, Bureau of Land Management or by a decree of a Court of Law and/or that the corner points mentioned in lines 3, 4 and 5 above were in conformance with the rules of the Michigan Board of Land Surveyors or by a Decree of a Court of Law; established, re-established, monumented, re-monumented, recovered, found as expressed below:

	A	B	C	D	E	F	G	H	I	J	K	L	M
2	6		5		4		3		2		1		
3													
4	7		8		9		10		11		12		
5													
6	18		17		16		15		14		13		
7													
8	19		20		21		22		23		24		
9													
10	30		29		28		27		26		25		
11													
12	31		32		33		34		35		36		
13													

NOTE: Not more than 4 corners, all in the same town and range, may be recorded on this certificate.

A. Description of original monument and accessories and/or subsequent restoration:


- A-2. Quarter corner common to Sections 1 and 6. 1909: C. Cummings, Co. Surveyor. Gives proportioned distances for west line of Section 6. No mention of monuments or witnesses.
- A-3. Section corner common to Sections 1, 12, 6 and 7. 1909: C. Cummings, Co. Surveyor. Gives proportioned distances for west line of Section 6. No mention of monuments or witnesses.
- 10. South One-sixteenth corner common to Sections 1 and 6. Not set in original survey, no evidence of subsequent establishment.

B. Description of corner evidence found and/or method applied in restoring or reestablishing corner:

- A-2. No evidence of original survey or restoration found. Corner position re-established by single proportionate measurement between the Northwest and Southwest corners of Section 6. Corner falls at angle point of a power line and falls on the east and south edges of the right of way clearing.
- A-3. Found 1 1/2" iron pin and two witnesses. It has been used in the survey of the power line and is similar to the iron pin found 1 mile north. Accepted found iron pin and set DNR monument beside it. The found witnesses were cut down during power line clearing and construction. Distance to north is 34.8 feet short of Cummings proportioned distances.
- 10. Corner position established mid-point and on-line between the Southwest and West Quarter corners of Section 6. Corner falls on east edge of power line clearing and was placed in a mound of stones. Tower pole witness is stamped "18335" and "167L 30-85 1000". Distance is measured to face of pole.

C. Description of monument for corner and accessories established to perpetuate locating the position of the corner:

A-2. DNR monument	A-3. DNR monument	10. DNR monument
9" W. Pine N81E 74.35'	9" J. Pine N76E 108.9'	9" W. Pine N53E 22.4'
8" R. Maple S79E 21.7'	9" W. Pine S10W 84.45'	6" J. Pine N88E 17.7'
5" W. Pine S44E 13.7'	8" B. Spruce S83W 88.7'	9" W. Pine S08E 29.4'
5" W. Pine S55W 1.3'	E'ly bolt on N17W 104.6'	E'ly tower pole N88W 60.35'
	E'ly foot of tower	

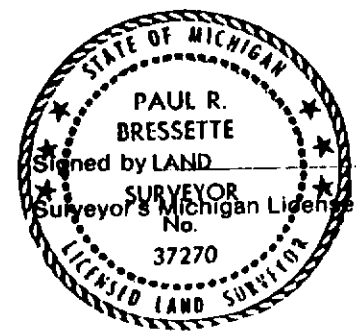

*Paul R. Bressette* Date 9-30-93

Surveyor's Michigan License No. 37270