

MARQUETTE COUNTY
MICHIGAN
RECEIVED FOR RECORD

1993 SEP 30 PM 4: 39

LAND CORNER RECORDATION CERTIFICATE
Filing Requirement of Act 74, Mich. P.A. 1970

Patricia R. Monney
REGISTER OF DEEDS

For corners in

Marquette (County) Located In: Corner Code //

1. Public Land Survey T 45N R 25W A-1, C-1, C-3
T R
T R
T R

2. Property Controlling S T R
in Section S T R


3. Miscellaneous S T R
Property in Sec. S T R

4. Lot No. _____, Recorded Plat _____

5. Private Claims _____

Libery 5 R.C. Page 382

Register of Deeds Stamp & File Number

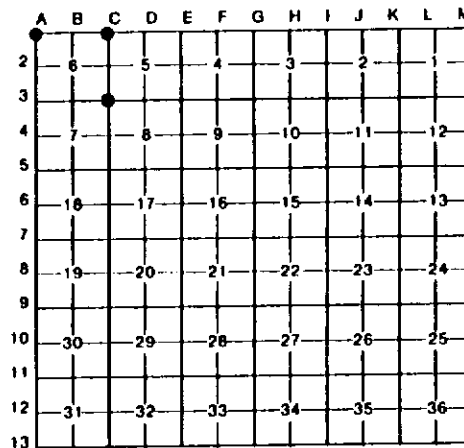

I, Paul R. Bressette, in a field survey on August-September, 19 93, do hereby certify that under requirements of P.A. 74, Michigan P.A. of 1970, the corner points mentioned in lines 1 and 2 above were in conformance with regulations and rules therefore as required in the current manual of survey instructions of the United States Department of the Interior, Bureau of Land Management or by a decree of a Court of Law and/or that the corner points mentioned in lines 3, 4 and 5 above were in conformance with the rules of the Michigan Board of Land Surveyors or by a Decree of a Court of Law; established, re-established, monumented, re-monumented, recovered, found as expressed below:

NOTE: Not more than 4 corners, all in the same town and range, may be recorded on this certificate.

A. Description of original monument and accessories and/or subsequent restoration:

A-1. Section Corner common to Sections 1,6,31 and 36. 1909: C. Cummings, County Surveyor. Set corner from W. Pine stump showing government markings. No mention of monument or witnesses.

C-1. Section corner common to Sections 5,6,31 and 32. 1954: Michigan Department of Conservation. Set 1" iron pipe with 4" brass cap witnessed by: 9" Tamarack N37E 32 links; 9" Cedar S67W 14 links.

C-3. Section corner common to Sections 5,6,7 and 8. 1852: Martin M. Hall, D.S. Set Mountain Ash post witnessed by: Y. Birch 10 S54W 22 links; W. Birch 18 N74E 45 links.

B. Description of corner evidence found and/or method applied in restoring or reestablishing corner:

A-1. Found 1½" iron pin used in survey of power line and in previous DNR surveys. Distance east to corner set from original evidence and also tied in by Cummings checks within 1.7 feet. Corner falls on west edge of power line clearing. Tower pole witness is stamped "18341" and "168R 30-85 1000." Distance is measured to face of pole.

C-1. Found monument and witnesses as described. SW NBT is down and laying south of monument. Rewitnessed monument as found.

C-3. No evidence of original survey or restoration found. Corner position re-established by single proportion measurement between the Southwest corner of Section 8 and the Northwest corner of Section 5. This position fits terrain calls in all four directions very well.

C. Description of monument for corner and accessories established to perpetuate locating the position of the corner:

A-1. DNR monument.


W'ly tower pole	S83E	60.55'
11" Cherry	S03W	12.6'
17" W. Pine	N84W	3.35'
17" W. Pine	N01W	44.65'

C-1. DNR monument

7" Tamarack	N30E	33.8'
15" Tw. Cedar	S80E	63.4'
8" Cedar	S15W	78.3'
12" Tamarack	N27W	21.0'

C-3. DNR monument

8" Spruce	N79E	57.65'
5" W. Birch	S45E	15.4'
4" Balsam	S58W	10.7'
7" Spruce	N14W	32.5'

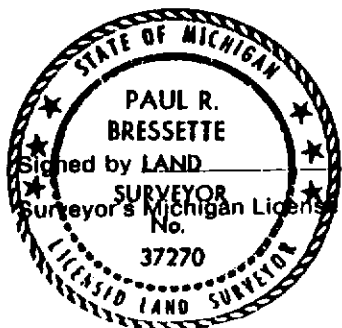

Paul R. Bressette Date

9-30-93

Surveyor's Michigan License No. 37270