

**SURVEY & REMONUMENTATION**

MARQUETTE COUNTY MICHIGAN RECEIVED FOR RECORD

JOB NUMBER: 94030 SHEET NO. : 1-535

**LAND CORNER RECORDATION CERTIFICATE**  
Filing Requirement of Act 74, Mich. P.A. 1970

1994 DEC 28 PM 5:59

APR 28 1995

For corners in

*Patricia A. Monley*  
REGISTER OF DEEDS

MARQUETTE (County)	Located In:	Corner Code #
COMMISSION	T 45N, R 25W	C-1:
	T _____ R _____	_____
	T _____ R _____	_____
	T _____ R _____	_____
	T _____ R _____	_____
2. Property Controlling in Section	S _____ T _____ R _____	_____
	S _____ T _____ R _____	_____
3. Miscellaneous Property in Sec.	S _____ T _____ R _____	_____
	S _____ T _____ R _____	_____

LIBER 1 PAGE 201 Register of Deeds Stamp & File Number

4. Lot No. \_\_\_\_\_, Recorded Plat \_\_\_\_\_  
5. Private Claims \_\_\_\_\_

	A	B	C	D	E	F	G	H	I	J	K	L	M
2	6	5	4	3	2	1							
3													
4	7	6	5	4	3	2	1						
5													
6	8	7	6	5	4	3	2	1					
7													
8	9	8	7	6	5	4	3	2	1				
9													
10	10	9	8	7	6	5	4	3	2	1			
11													
12	11	10	9	8	7	6	5	4	3	2	1		
13													

GERALD W. CARLSON, in a field survey on Monday, December 12, 1994

do hereby certify that under requirements of P.A. 74, Michigan P.A. of 1970, the corner points mentioned in lines 1 and 2 above were in conformance with regulations and rules therefore as required in the current manual of survey instructions of the United States Department of the Interior, Bureau of Land Management or by a decree of a Court of Law and/or that the corner points mentioned in lines 3, 4 and 5 above were in conformance with the rules of the Michigan Board of Land Surveyors or by a Decree of a Court of Law; established, re-established, monumented, re-monumented, recovered, found as expressed below:

**NOTE: Not more than 4 corners, all in the same town and range, may be recorded on this certificate.**

**1. Description of original monument and accessories and/or subsequent restoration:**

C-1: Section Corner common to Sections 5 and 6, T45N-R25W; 1909: C. Cummings indicates a corner set from stump of and Sections 31 and 32, T46N-R25W. 1844: William A. Burt's gov't Cedar B.T.. No monument or accessories given. original survey notes describe the corner monument as a Distance west 5172' from Cummings notes. (See reverse side.) wood post referenced by: (See reverse side)  
14" Cedar N17E, 18 1  
15" Cedar N64W, 37 1

**2. Description of corner evidence found and/or method applied in restoring or reestablishing corner:**


1994- Found and accepted DNR monument as witnessed by P. Bressette. Distance East is 2632.14' (2632.26' DNR) and distance West is 5171.27' (5173.30'-DNR calculated).

**RATIFIED BY PEER GROUP**  
**P.A. 345 OF 1990**  
*Lenny J. Bressette*  
DATE Sept 26, 1994

**3. Description of monument for corner and accessories established to perpetuate locating the position of the corner:**

1994 - Found a 1 1/4" diameter iron with a 4" diameter cap stamped to identify the corner referenced by nails in:  
7" Cedar S15W 78.45 ft. Bressette NBT  
20" Tamarack N34W 22.05 ft. Bressette NBT (forked tree)  
7" Tamarack N31E 34.00 ft. Bressette NBT  
11" Twin Cedar S79E 63.92 ft. Bressette NBT  
Steel sign post Due North 3.0 ft.  
Monument falls in a small swampy clearing and is 1.0' above ground. Stamped monument "MCR 1994" (Marquette County Remonumentation).  
Bk. 6, Pg. 135

Signed by Gerald W. Carlson Date 12-22-94  
Surveyor's Michigan License No. 24589

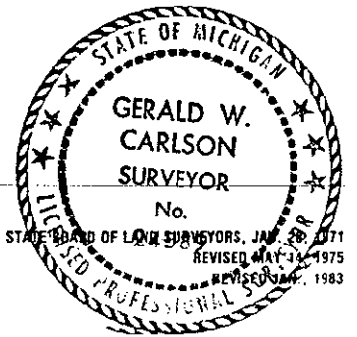

Record No. 535

Part "A" Continued:

1953: Michigan Department of Conservation set a 1" pipe with 4" brass cap from one original B.T., still in place, down, in good condition. Referenced by:

9" Tamarack	N37E 32 l
9" Cedar	S67W 14 l

1993: P. Bressette P.S. No. 37270: Found 1954 Michigan Department of Conservation 1" iron pipe with 4" brass cap witnessed by: 9" Tamarack N37E 32 links; 9" Cedar S67W 14 links. SW NBT is down and laying south of monument. Rewitnessed monument as found:

7" Tamarack	N30E 33.8'
15" Tw. Cedar	S80E 63.4'
8" Cedar	S15W 78.3'
12" Tamarack	N27W 21.0'

L. 5, R.C. P. 382

*2# 600  
Geo  
Dec 1993*