

SURVEY & REMONUMENTATION

MARQUETTE COUNTY
MICHIGAN
RECEIVED FOR RECORD

JOB NUMBER: 94030

SHEET NO. : 1-537

LAND CORNER RECORDATION CERTIFICATE

APR 28 1995 Filing Requirement of Act 74, Mich. P.A. 1970

1994 DEC 28 PM 5:59

For corners in

Patricia A. Monks
REGISTER OF DEEDS

MARQUETTE (County)	COMMISSION	#	Corner Code #
1. Public Land Survey	T <u>45N</u> R <u>25W</u>		E-1: _____
	T _____ R _____		_____
	T _____ R _____		_____
	T _____ R _____		_____
2. Property Controlling in Section	S _____ T _____ R _____		_____
	S _____ T _____ R _____		_____
3. Miscellaneous Property In Sec.	S _____ T _____ R _____		_____
	S _____ T _____ R _____		_____

LIBER **1** PAGE **203**
Register of Deeds Stamp & File Number

4. Lot No. _____, Recorded Plat _____
6. Private Claims _____

	A	B	C	D	E	F	G	H	I	J	K	L	M
2	6	5	4	3	2	1							
3													
4	7	8	9	10	11	12							
5													
6	18	17	16	15	14	13							
7													
8	19	20	21	22	23	24							
9													
10	30	29	28	27	26	25							
11													
12	31	32	33	34	35	36							
13													

GERALD W. CARLSON in a field survey on Monday, December 12, 1994, do hereby certify that under requirements of P.A. 74, Michigan P.A. of 1970, the corner points mentioned in lines 1 and 2 above were in conformance with regulations and rules therefore as required in the current manual of survey instructions of the United States Department of the Interior, Bureau of Land Management or by a decree of a Court of Law and/or that the corner points mentioned in lines 3, 4 and 5 above were in conformance with the rules of the Michigan Board of Land Surveyors or by a Decree of a Court of Law; established, re-established, monumented, re-monumented, recovered, found as expressed below:

NOTE: Not more than 4 corners, all in the same town and range, may be recorded on this certificate.

A. Description of original monument and accessories and/or subsequent restoration:

E-1: Section Corner common to Sections 4 and 5, T45N-R25W 1942: MCRC F.B. 712. Remains of S. Pine B.T. 8 S45W, 32 1 and Sections 32 and 33, T46N-R25W. 1844: William A. Burt's original survey notes describe the corner monument as a 4" diameter White Pine referenced by: 8" S. Pine S45W, 32 1
 can be seen and deciphered. Tree has decayed and fallen and fallen and is now almost completely gone to decay. The markings are still in evidence. Set a 1" iron pipe on ledge and set new B.T.'s:
 9" W. Pine S15W, 34.5'
 8" W. Pine N31W, 8.9'
 (See reverse side.)

B. Description of corner evidence found and/or method applied in restoring or reestablishing corner:

1994: Found and accepted DNR monument as placed by P. Bressette. Distance East is 2632.35' and distance West is 2632.17' (2632.26'-DNR).

**CERTIFIED BY PEER GROUP
P.A. 345 OF 1990**

Henry J. Bressette
DATE Sept 26, 1994


C. Description of monument for corner and accessories established to perpetuate locating the position of the corner:

1994 - Found Department of Natural Resources iron pipe with aluminum cap in place referenced by nails in:
 15" Red Pine N38E 38.42 ft. Bressette NBT
 11" White Pine S56W 45.01 ft. Bressette NBT
 8" Jack Pine S05W 27.01 ft. Bressette NBT
 7" Red Pine S30E 38.91 ft. Bressette NBT
 Steel sign post N06W 4.27 ft.
 Monument is 0.3' above ground and is located on North side of rock knob. Stamped MCR 1994 on cap of monument (Marquette County Remonumentation).
 Bk. 6, Pg. 131

igned by *Gerald W. Carlson*

Date 12-22-94

urveyor's Michigan License No. 24589

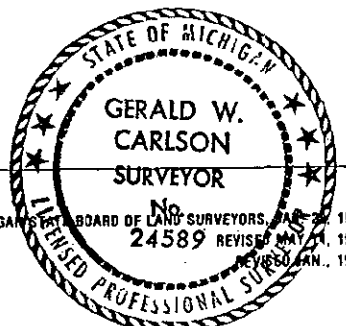

Record No. 537

*AP # 6.
DNR
Jan 24/14*

Part "A" Continued:

1993: P. Bressette P.S. No. 37270: Found 1" iron pipe and NBT's: W. Pine 9 S15W 34.5'; W. Pine 8 N31W 8.9'. Both NBT's dead but still standing. Replaced iron pipe with DNR monument and witnessed:

16" R. Pine	N44E	37.9'
8" R. Pine	S26E	39.0'
8" J. Pine	S10W	26.7'
10" W. Pine	S54W	44.6'

L. 5, R.C. P. 385