

SURVEY & REMONUMENTATION

MAR 13 1998

MARQUETTE COUNTY
MICHIGAN
RECEIVED FOR RECORD

1997 DEC 26 PM 12:45

SECTION

LAND CORNER RECORDATION CERTIFICATE
Filing Requirement of Act 74, Mich. P.A. 1970

For corners in MARQUETTE (County) Located In: _____ Corner Code # _____

1. Public Land Survey T 45N R 25W _____ G-4
 T _____ R _____
 T _____ R _____
 T _____ R _____

2. Property Controlling S _____ T _____ R _____
 in Section S _____ T _____ R _____

3. Miscellaneous S _____ T _____ R _____
 Property in Sec. S _____ T _____ R _____

4. Lot No. _____, Recorded Plat _____

5. Private Claims _____

Patricia A. Morley
REGISTER OF DEEDS

LIBER 2 PAGE 15
Register of Deeds Stamp & File Number

I, GERALD W. CARLSON, in a field survey on DECEMBER 12, 19 97, do hereby state that under requirements of P.A. 74, Michigan P.A. of 1970, the corner points mentioned in lines 1 and 2 above were in conformance with regulations and rules therefore as required in the current manual of survey instructions of the United States Department of the Interior, Bureau of Land Management or by a decree of a Court of Law and/or that the corner points mentioned in lines 3, 4 and 5 above were in conformance with the rules of the Michigan Board of Land Surveyors or by a Decree of a Court of Law; established, re-established, monumented, recovered, found as expressed below:

A	B	C	D	E	F	G	H	I	J	K	L	M
1												
2	6	5	4	3	2	1						
3												
4	7	8	9	10	11	12						
5												
6	18	17	16	15	14	13						
7												
8	19	20	21	22	23	24						
9												
10	30	29	28	27	26	25						
11												
12	31	32	33	34	35	36						
13												

NOTE: Not more than 2 corners, all in the same town and range, may be recorded on this certificate.

A. Description of original monument and accessories and/or subsequent restoration:
G-4: Quarter Corner common to Sections 9 and 10.

1852: Martin M. Hall's original subdivision survey notes describe the corner monument as a Spruce post referenced by:
14" Spruce N42W, 10 L 28" W. Pine S63E, 23 L

1942: Survey field notes from M.C.R.C. F.B. #712 (No pg. given) indicate that the corner was set 10' West of a road. No description of corner object was given. Heilala notes that, "All corners (set at this time in this township by the M.C.R.C.) were set in accordance with the U.S. Field Notes where such notes could be used. Locations of lakes, rivers, sloughs, swamps, and hills were considered in locating the corners, and I believe they are set as close as possible to the original locations. In a few places very old squared trees were found decayed and windfallen, but in most places all evidence has been destroyed by forest fires." Established references:
6" J. Pine N30W, 30.2' 5" J. Pine S70E, 37.0'

(SEE REVERSE SIDE)

RATIFIED BY PEER GROUP
P.A. 345 OF 1990

Larry J. Brasme
DATE 12/15/97

B. Description of corner evidence found and/or method applied in restoring or reestablishing corner:

G-4: 1997: No original corner evidence found. Found 5/8" x 18" Iron and a 1" Pipe lying flat on ground. Found decayed 6" J. Pine MCRC stump with town and range scribing facing due South (MCRC N30W, 30.2') measured N06W, 30.45'. Checked Line Call: (North, 8.50 chains {561.0'} top of ledge 15' S.W.) Measured call: North 531.6' to rock knob. There were no other nearby line calls available to check. Set a 2 3/8" O.D. aluminum pipe capped with a 3 1/4" diameter aluminum tablet Marquette County Survey Monument stamped to identify the corner. The corner position was re-established on the straight line between the found N.W. and S.W. corners of Section 10 at the MCRC distance from the found scribed Jack Pine stump. Distance North is 2632.96' and distance South is 2634.95'.

C. Description of monument for corner and accessories established to perpetuate locating the position of the corner:


G-4: 1997: Set a 2 3/8" O.D. aluminum pipe capped with a 3 1/4" diameter aluminum tablet Marquette County Survey Monument stamped to identify the corner. Monument is located 10' West of gravel road and is 0.2' above ground. Measured existing reference:
6" J. Pine (stump) N03W, 30.48' (to GPS TCI in C/L) (MCRC NBT w/scribing)

Established new references:

- 11" W. Pine S71W, 110.24' (to set d.h. nails)
- 12" R. Pine N07E, 60.45' (to set d.h. nails)
- 10" R. Pine N83E, 118.66' (to set d.h. nails)
- 11" W. Pine S44E, 95.22' (to set d.h. nails)

Green Steel Sign Post w/ Yellow Survey Marker Sign N81W, 2.0'
Note: Bearing trees have painted orange face, butt, and side nail blazes, d.h. measuring nails, and stamped B.T. Tags affixed.

Ek. 13, Pg. 47-48

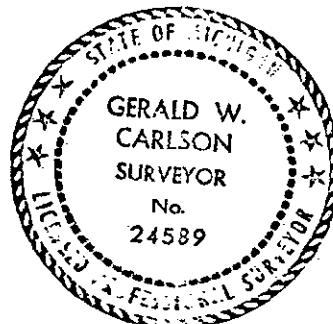

Signed by Gerald W. Carlson Date 12-18-97

G-4

PART A CONTINUED:

No Date: The M.C.R.C. Government Corner Index Book (F.B. #643 - Sec. 9) indicates the corner as a 1" Iron Pipe and J. Pine Post 10' West of a road.
Referenced by:

6" J. Pine N30W, 30.2' 5" J. Pine S70E, 37.0'

1981: An unrecorded LCRC by William R. Donnan, P.S. #17618, references the corner as being used to establish the position of the N.W. corner of Section 15 by double proportionate measure between the N.W. Cor. of Sec. 16, and the N 1/4 Cor. of Sec. 15 and the E1/4 Cor. of Sec. 9 and the E1/4 Cor. of Sec. 16 (see calculation sheets from the files of Gordie/Faser & associates).