

**SURVEY &
REMONUMENTATION**

MARQUETTE COUNTY
MICHIGAN
RECEIVED FOR RECORD

APR 28 1995

LAND CORNER RECORDATION CERTIFICATE
Filing Requirement of Act 74, Mich. P.A. 1970

1994 DEC 29 PM 1:55

or corners in

Marquette **COMMISSION** Located In: Corner Code #

Patricia A. Morley
REGISTER OF DEEDS

Public Land Survey	T	45N	R	25W	I-2
	T		R		
	T		R		
	T		R		
Property Controlling in Section	S		T		R
Miscellaneous	S		T		R
Property in Sec.	S		T		R

RATIFIED BY PEER GROUP
P.A. 345 OF 1990

Larry J. Bussone
DATE Sept 12, 1994

LIBER **1** PAGE **211**
Register of Deeds Stamp & File Number

Lot No. _____, Recorded Plat _____
Private Claims _____

Michael Mileski, in a field survey on September 94, 19____

hereby certify that under requirements of P.A. 74, Michigan P.A. of 1970, the corner points mentioned in lines 1 and 2 above were in conformance with regulations and rules therefore as required in the current manual of survey instructions of the United States Department of the Interior, Bureau of Land Management or by a decree of a Court of Law and/or that the corner points mentioned in lines 3, 4 and 5 above were in conformance with the rules of the Michigan Board of Land Surveyors or by a Decree of a Court of Law; established, re-established, monumented, re-monumented, recovered, found as expressed below:


NOTE: Not more than 4 corners, all in the same town and range, may be recorded on this certificate.

	A	B	C	D	E	F	G	H	I	J	K	L	M
2	6		5		4		3	●	2		1		
3													
4	7		8		9		10		11		12		
5													
6	13		17		16		15		14		13		
7													
8	19		20		21		22		23		24		
9													
10	30		29		28		27		26		25		
11													
12	31		32		33		34		35		36		
13													

Description of original monument and accessories and/or subsequent restoration:

I-2; West One-Quarter Corner Section 2;

See back of form.

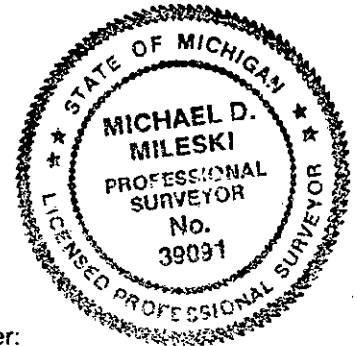

Description of corner evidence found and/or method applied in restoring or reestablishing corner:

I-2; West One-Quarter Section 2;

Found 1" iron pipe consistent in form to previously recovered M.C.R.C. monumentation. Found no evidence of U.S. or M.C.R.C. accessories. Monument is within 3 feet of the M.C.R.C.'s intended position.

State Plane Coordinates:

Grid System - NAD 83
Zone Number - 2111 Michigan North
Units - International Feet
Y = 562633.67665
X = 26143707.94979

Description of monument for corner and accessories established to perpetuate locating the position of the corner:

I-2; West One-Quarter Section 2;

Set 2" I.D. x 30" aluminum pipe with 3" aluminum cap (Berntsen A1NB30) appropriately stamped as to location.

Set 60d spike	W/side	7" Jack Pine	N24°E	32.10'
Set 60d spike	S/side	4" Red Pine	S45°E	11.91'
Set 60d spike	N/side	8" Jack Pine	S70°W	58.48'
Set 60d spike	W/side	3" Red Pine	N39°W	33.95'
		Location Post	North	1.5'

All of the above new bearing trees marked with upper and lower face blazes and scribed "NBT".

Surveyed by Michael Mileski Date 21 Nov 1994
Surveyor's Michigan License No. 39091


A. Description of original monument and accessories and/or subsequent restoration:

I-2; West One-Quarter Corner Section 2;

Originally established during U.S. Survey conducted by Martin Hall, D.S. in 1852 and monumented with a spruce pine post witnessed by a Spruce Pine 12 S53°W 37 lks. and a Spruce Pine 12 N67°E 31 lks.

This corner was remonumented with a 1" iron pipe and jack pine post on 16 December 1941 by the Marquette County Road Commission at a position intended to be perpendicular to the north township line at a distance of 2702.7 feet from the northwest corner of section 2. Marquette County Road Commission field notes indicate that the west line of section 2 so determined would be parallel to the east line of section 1. Refer to M.C.R.C. field book 712 pages 9 & 10.

Since the M.C.R.C. remonumented the southwest corner of section 2 on the same line at record U.S. distance from the northwest corner of section, it is probable that they intended to remonument the west one-quarter corner of section 2 at record U.S. distance (40.91 chains - 2700.06 feet) from the northwest corner of section 2. The record U.S. distance for the entire west line of section 2 is 80.95 chains. The M.C.R.C. distance of 2702.7 feet may arise from the incorrect determination of the length of the north one-half of the west line of section 2 as $80.95 \text{ ch} - 40.00 \text{ ch} = 40.95 \text{ ch} = 2702.7 \text{ feet}$.

However, record U.S. distance for the south one-half mile of the west line of section 2 is 40.04 chains.

The M.C.R.C. noted the following new bearing trees:

- 4" Jack Pine N32°W 23.0'
- 4" Jack Pine S16°E 13.1'