

**SURVEY &  
REMONUMENTATION**

MARQUETTE COUNTY  
MICHIGAN  
RECEIVED FOR RECORD

APR 28 1995

**LAND CORNER RECORDATION CERTIFICATE**

1994 DEC 29 PM 1:55

Filing Requirement of Act 74, Mich. P.A. 1970

or corners in

Marquette  
(County)

**COMMISSION**

Located in:

Corner Code #

Public Land Survey	T	45N	R	25W	1-3
	T		R		
	T		R		
	T		R		
Property Controlling in Section	S		T	R	
	S		T	R	
Miscellaneous	S		T	R	
Property in Sec.	S		T	R	

*Patricia R. Monley*  
REGISTER OF DEEDS

**RATIFIED BY PEER GROUP  
P.A. 345 OF 1990**

*Larry J. Bussone*  
DATE Sept 12, 1994

LIBER **1** PAGE **213**  
Register of Deeds Stamp & File Number

Lot No. \_\_\_\_\_, Recorded Plat \_\_\_\_\_  
Private Claims \_\_\_\_\_



Michael Mileski, in a field survey on September 94, 1994

do hereby certify that under requirements of P.A. 74, Michigan P.A. of 1970, the corner points mentioned in lines 1 and 2 above were in conformance with regulations and rules therefore as required in the current manual of survey instructions of the United States Department of the Interior, Bureau of Land Management or by a decree of a Court of Law and/or that the corner points mentioned in lines 3, 4 and 5 above were in conformance with the rules of the Michigan Board of Land Surveyors or by a Decree of a Court of Law; established, re-established, monumented, re-monumented, recovered, found as expressed below:

**NOTE: Not more than 4 corners, all in the same town and range, may be recorded on this certificate.**

Description of original monument and accessories and/or subsequent restoration:

I-3; Southwest Corner Section 2;  
See back of form.

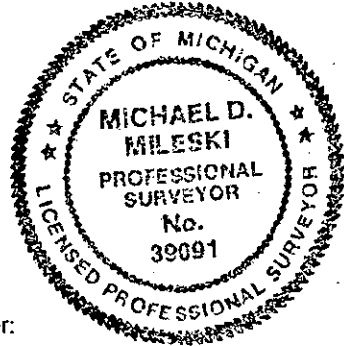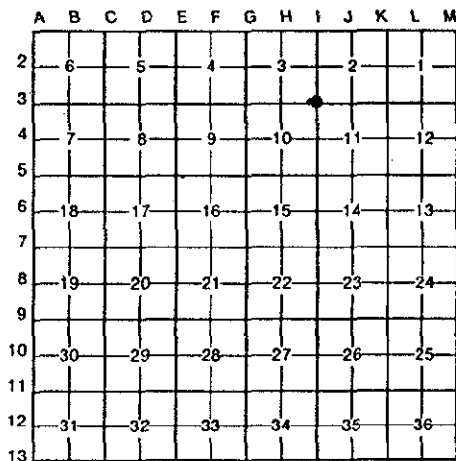

Description of corner evidence found and/or method applied in restoring or reestablishing corner:

I-3; Southwest Corner Section 2;

Found a 1" iron pipe consistent in form with previously recovered M.C.R.C. monumentation projecting 12 inches above ground. No U.S. or M.C.R.C. bearing trees were recovered. The recovered iron pipe is at M.C.R.C. record distance (414 feet) west of the centerline of old County Road 553.

State Plane Coordinates:  
Grid System - NAD 83  
Zone Number - 2111 Michigan North  
Units - International Feet  
Y = 559996.87350  
X = 26143691.86220

Description of monument for corner and accessories established to perpetuate locating the position of the corner:

I-3; Southwest Corner Section 2;

Replaced found 1" iron pipe with 2" I.D. x 30" aluminum pipe with 3" aluminum cap (Berntsen A1NB30) appropriately stamped as to location.

Set 60d spike	N/side	10" Jack Pine	S79°E	63.98'
Set 60d spike	E/side	7" Jack Pine	S16°E	94.98'
Set 60d spike	S/side	4" Jack Pine	S88°W	93.84'
Set 60d spike	W/side	7" Jack Pine	N18°W	41.03'
		Location Post	North	1.5'

All of the above new bearing trees marked with upper and lower face blazes and scribed "NBT".

Surveyed by Michael Mileski Date 21 Nov 1994

Surveyor's Michigan License No. 39091

Ref 6476  
Geo  
J. H. Kim

A. Description of original monument and accessories and/or subsequent restoration:

I-3; Southwest Corner Section 2;

Originally established during U.S. Survey conducted by Martin Hall, D.S. in 1852 and monumented with a wood post witnessed by a Spruce Pine 12 S53°W 10 lks. and a Spruce Pine 12 N22°E 26 lks.

This corner was remonumented with a 1" iron pipe and jack pine post on 16 December 1941 by the Marquette County Road Commission at a position intended to be perpendicular to the north township line at record U.S. distance (80.45 chains) from the northwest corner of section 2. Marquette County Road Commission field notes indicate that the west line of section 2 so determined would be parallel to the east line of section 1. Refer to M.C.R.C. field book 712 pages 9, 10 & 20.

The M.C.R.C. noted the following new bearing trees:

- 3" Jack Pine S41°W 18.5'
- 4" Jack Pine N52°W 20.7'