

SURVEY & REMONUMENTATION

MAR 13 1998

MARQUETTE COUNTY MICHIGAN RECEIVED FOR RECORD

1997 DEC 26 PM 12: 45

SECTION

LAND CORNER RECORDATION CERTIFICATE Filing Requirement of Act 74, Mich. P.A. 1970

For corners in

MARQUETTE

(County)

Located In:

Corner Code #

1. Public Land Survey

T 45N R 25W

K-4

2. Property Controlling in Section

S T R

3. Miscellaneous

S T R

Property in Sec.

S T R

4. Lot No. , Recorded Plat

5. Private Claims

Patricia L. Mosbey REGISTER OF DEEDS

LIBER 2 PAGE 22 Register of Deeds Stamp & File Number

I, GERALD W. CARLSON, in a field survey on June 11TH, 19 97, do hereby state that under requirements of P.A. 74, Michigan P.A. of 1970, the corner points mentioned in lines 1 and 2 above were in conformance with regulations and rules therefore as required in the current manual of survey instructions of the United States Department of the Interior, Bureau of Land Management or by a decree of a Court of Law and/or that the corner points mentioned in lines 3, 4 and 5 above were in conformance with the rules of the Michigan Board of Land Surveyors or by a Decree of a Court of Law; established, re-established, monumented, recovered, found as expressed below:

NOTE: Not more than 2 corners, all in the same town and range, may be recorded on this certificate.

A. Description of original monument and accessories and/or subsequent restoration:

K-4: Quarter Corner common to Sections 11 and 12.

1852: Martin M. Hall's original subdivision survey notes describe the corner monument as a Spruce Pine post referenced by:

12" Spruce Pine S39W, 15 L 12" Spruce Pine N58E, 7 L

No Date: Survey field notes from M.C.R.C. F.B. #573, pg. 75 indicate the corner as a Stump of squared Jack Pine. Tree decaying on ground. Blazes very old.

1942: Survey field notes from M.C.R.C. F.B. #712 (No pg. given) indicate the corner as an Iron Pipe and old post. No accessories given.

No Date: The M.C.R.C. Government Corner Index Book (F.B. #643 - Sec. 11) indicates the corner as an Iron Pipe and old post. No accessories given. The index also indicates a 1" Iron Pipe with Aluminum Cap by Ed Kazianka P.S. #14765 (11/8/68) for Kimberly Clark Corp. Referenced by:

6" J. Pine N77W, 91 L (60.06') (NBT) 7" J. Pine S48E, 33 L (21.78') (NBT)

No Date: The corner is indicated on an unidentified sketch of Co. Rd. 553. No description of corner object or accessories given.

B. Description of corner evidence found and/or method applied in restoring or reestablishing corner:

K-4: 1997: No original corner evidence found. Found and accepted a 1 1/4" O.D. Galvanized Iron Pipe, 1.0' high, capped with a 4" diameter aluminum tablet stamped to identify the corner (Set by Ed Kazianka, P.S. #14765 in 1968). Also found a 2" I.D. Iron Pipe with top painted orange, 2.5' high, 0.5' N.E.'LY from monument. Found two existing references as noted in Part C below. Checked Line Call: South, 1.14 chains (75.24'), Descend Hill Course S.W.. Measured Line Call: Began descent 72' South of corner. Checked Line Call: South, 10.14 chains (669.24'), Foot of Hill 80' and opposite lake 100 links (66') East of line. Measured Line Call: Measured South, 677' to foot of hill at N.'LY end of N.E. and S.W. hill. Line is +/- 65' East of edge of small lake (opposite direction of that noted in GLO notes). Distance North is 2637.81' and distance South is 2630.15'.

C. Description of monument for corner and accessories established to perpetuate locating the position of the corner:

K-4: 1997: Stamped "MCR 1997" on 4" diameter aluminum monument described in Part B above. Set d.h. measuring nails in old nail blazes in found references:

11" J. Pine N77W, 60.07' (Fd. Scribes "NBT" in butt blaze, "1/4 S 11" in face blaze) (Kazianka NBT)

12" J. Pine S44E, 21.79' (Fd. Scribes "BT" in butt blaze, "1/4 S 12" in face blaze) (Kazianka NBT)

Established new references:

12" J. Pine S86E, 10.17' (d.h. nail S.'LY side, 1.5' high)

9" J. Pine NOOE, 26.44' (d.h. nail E.'LY side, 1.5' high)

Green Steel Sign Post w/ Yellow Survey Marker Sign N19W, 3.05' to C/L


Note: Bearing trees have painted face, butt, and side nail blazes, d.h. measuring nails, and stamped B.T. Tags affixed. Bk. 12, Pg. 1.

Grid table with columns A-L and rows 1-13. A dot is marked at row 4, column K.

RATIFIED BY PEER GROUP

P.A. 345 OF 1990

Larry J. Busceme DATE 12/8/97

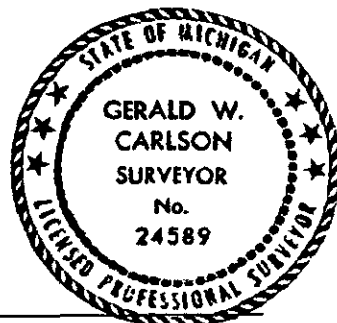

Signed by Gerald W. Carlson

Date 12-18-97

Surveyor's Michigan License No. 24589