

MICHIGAN
DEPARTMENT OF CONSERVATION
FORESTRY DIVISION

LAND CORNER RECORD

T. 45-46 N. R. 26W


Marquette COUNTY

DESCRIPTION OF CORNER Section Corner common to Sections 4-5-32-33

CORNER MONUMENT 1" Pipe with 4" Aluminum Cap.

DATE MONUMENT PLACED AND WITNESSED 6/21/67

WITNESSES TO CORNER..... 30" W. Pine (1"BT) N2°W 10.1'

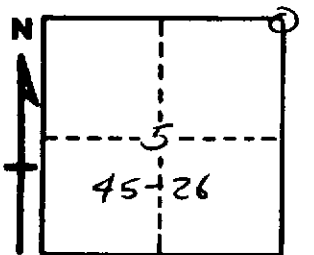

20" W. Pine " S60°E 25.6'

AND

CIRCLE CORNER REGISTERED

DESCRIPTION IN DETAIL AS TO HOW CORNER WAS LOCATED AND IDENTIFIED OR RESTORED.

This corner placed 80.00 chains East of a good
Section Corner on Twp. line.

Corner is temporary. Found no evidence in vicinity.

Corner lies 1 chain North of an old woods road & borrow pit.

SURVEYOR'S SEAL

SIGNED

Billy D. Buckler
Billy D. Buckler

REGISTERED LAND SURVEYOR

DATE

10/25/67