

✓

**MICHIGAN  
DEPARTMENT OF CONSERVATION  
FORESTRY DIVISION**

# LAND CORNER RECORD

T. 45-46 N.R. 26W


Marquette COUNTY

DESCRIPTION OF CORNER East 1/16 Corner between Sections 6-31

CORNER MONUMENT 1" Pipe with 4" Aluminum Cap.

DATE MONUMENT PLACED AND WITNESSED 6/21/67

WITNESSES TO CORNER..... 7" E. Spruce (1/16 FT) N2°W 13.9'

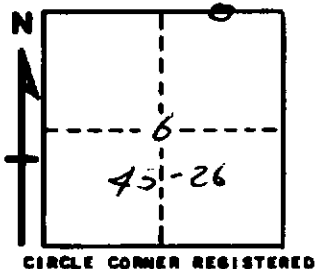

8" E. Spruce " East 9.1'

AND

**DESCRIPTION IN DETAIL AS TO HOW CORNER WAS LOCATED AND IDENTIFIED OR RESTORED.**

This corner placed midway and on line between Section  
Corner to East and 1/4 Corner to West.

Corner lies in spruce swamp.

**SURVEYOR'S SEAL**

SIGNED *Billy D. Buckler*  
Billy D. Buckler DATE 10/25/67  
REGISTERED LAND SURVEYOR