

RF

11-10-99

MARQUETTE COUNTY MICHIGAN RECEIVED FOR RECORD

1999 DEC 22 AM 11:23

SECTION

LAND CORNER RECORDATION CERTIFICATE Filing Requirement of Act 74, Mich. P.A. 1970

For corners in MARQUETTE (County) Located In: Corner Code #

- 1. Public Land Survey T 45N R 25W A-4 T 45N R 26W M-4 ✓

4. Lot No. , Recorded Plat 5. Private Claims

Patricia L. Manley REGISTER OF DEEDS

LIBER R2 PAGE 183

Register of Deeds Stamp & File Number

I, GERALD W. CARLSON, in a field survey on October 26th, 1999, do hereby state that under requirements of P.A. 74, Michigan P.A. of 1970, the corner points mentioned in lines 1 and 2 above were in conformance with regulations and rules therefore as required in the current manual of survey instructions of the United States Department of the Interior, Bureau of Land Management or by a decree of a Court of Law and/or that the corner points mentioned in lines 3, 4 and 5 above were in conformance with the rules of the Michigan Board of Land Surveyors or by a Decree of a Court of Law; established, re-established, monumented, recovered, found as expressed below:

NOTE: Not more than 2 corners, all in the same town and range, may be recorded on this certificate.

A. Description of original monument and accessories and/or subsequent restoration: A-4: Quarter Corner common to Section 7, T45N-R25W and Section 12, T45N-R26W. 1844: William A. Burt's original subdivision survey notes describe the corner monument as a wood post referenced by: 16" W. Pine S72W, 7L 6" Fir N61E, 3L

1909-1913: Survey notes by Charles Cummings indicate that the corner was reset using original GLO bearing trees.

No Date: A survey sketch of a transmission line through section 7 indicates a corner 264' North of the Escanaba river.

B. Description of corner evidence found and/or method applied in restoring or reestablishing corner: A-4: 1999: The stake out area landed on a granite knob. The area was searched thoroughly with a magnetic locator. No monument or original corner evidence found. Corner was set by single proportionate measurement between the Southwest corner of Section 6 and the Southwest corner of Section 7. Distance North and South are 2642.64'.


Line Call: South, 18.67 chains (1232.2'), over river and ascend granite ledge (call written working North from the Southwest corner of Section 7). With a hip chain we measured 758' South to the start of the granite ledge and 1308' to the edge of Escanaba River.

C. Description of monument for corner and accessories established to perpetuate locating the position of the corner: A-4: 1999: Set a 3/4" X 1.8' iron drilled and grouted in rock capped with a 3 1/4" diameter aluminum tablet Marquette County Survey Monument stamped to identify the corner. Monument is 0.5' above ground. Referenced by: 15" White Pine S39W, 32.79' 12" White Pine N55W, 35.52' 12" White Pine N23W, 4.39' 17" White Pine S76E, 49.98'

Green Steel Sign Post w/ Yellow Survey Marker Sign S48E, 9.46' Note: Bearing trees have painted face, butt, and side nail blazes, d.h. measuring nails, and stamped B.T. Tags affixed. T45N-R25W, Corner Search Report 99100 FB 15, Pg. 2-3 FB 12, Pg 126-127

Grid table with columns A-M and rows 1-13. Cell (4,7) contains a dot.

RATIFIED BY PEER GROUP P.A. 345 OF 1990 Larry G. Burson DATE 10/25/99

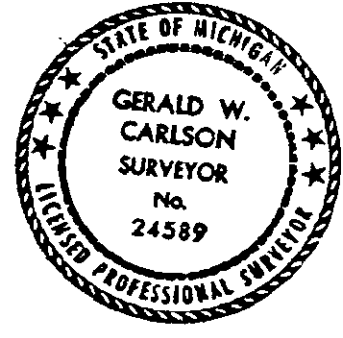

Signed by Gerald W. Carlson Date 12-8-99