

✓

**MICHIGAN  
DEPARTMENT OF CONSERVATION  
FORESTRY DIVISION**

# LAND CORNER RECORD

T. 45N N.R. 27W


Marquette COUNTY

DESCRIPTION OF CORNER 1/4 cor. bet. Secs. 33-34.

CORNER MONUMENT 1" pipe with 4" aluminum cap.

DATE MONUMENT PLACED AND WITNESSED 8/15/66

WITNESSES TO CORNER..... 17" red pine (1/4S NBT) N37°E 26.6'

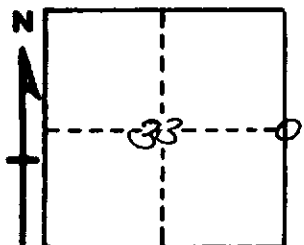

10" red pine (1/4S NBT) S57°W 21.4'

AND

CIRCLE CORNER REGISTERED

**DESCRIPTION IN DETAIL AS TO HOW CORNER WAS LOCATED AND IDENTIFIED OR RESTORED.**

This corner re-established midway and on line bet. two sec. cors.

Found several jack pine stumps in vicinity, but could identify no original evidence.

Corner lies 2 chs. north of an open marsh.

**SURVEYOR'S SEAL**

*Billy D. Buckler*

SIGNED Billy D. Buckler DATE 1/10/67  
REGISTERED LAND SURVEYOR