

MICHIGAN
DEPARTMENT OF CONSERVATION
FORESTRY DIVISION

LAND CORNER RECORD

T. 45N R. 27W


Marquette COUNTY

DESCRIPTION OF CORNER 1/4 Cor. bet. Secs. 13-14

CORNER MONUMENT 1" pipe with 4" aluminum cap.

DATE MONUMENT PLACED AND WITNESSED 8/17/66

WITNESSES TO CORNER..... 11" Red Oak (1/2 S NBT) N9°W 44.3'

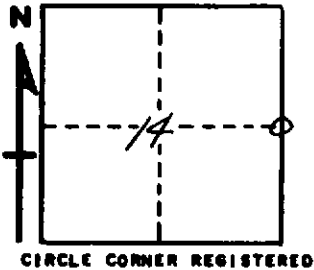

5" Soft Maple (1/2 S NBT) S80°E 22.4'

AND

DESCRIPTION IN DETAIL AS TO HOW CORNER WAS LOCATED AND IDENTIFIED OR RESTORED.

This corner replaced from one W. pine B.T., bearing N36°W 54 lks; a stub with both faces in evidence and a W. Pine stump bottom bearing S23°E 14 lks., no remaining marks, stump in poor condition.

Corner lies on top of hill as indicated in original notes.

SURVEYOR'S SEAL

Billy D. Buckler.
SIGNED Billy D. Buckler DATE 1/11/67
REGISTERED LAND SURVEYOR