

MICHIGAN
DEPARTMENT OF CONSERVATION
FORESTRY DIVISION

LAND CORNER RECORD

T. 45N N.R. 27W


Marquette COUNTY

DESCRIPTION OF CORNER Sec. Cor. for Secs. 26, 27, 34, 35

CORNER MONUMENT 1" iron pipe with 4" aluminum cap.

DATE MONUMENT PLACED AND WITNESSED 7/8/66

WITNESSES TO CORNER..... 7" Jack Pine (S 35) (NBT) S 19° E 59½ lks.

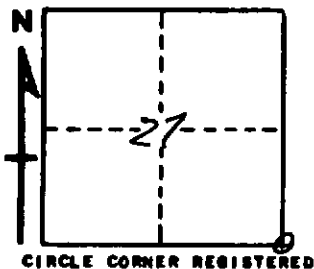

7" Jack Pine (S 34) (NBT) S 44° W 80½ lks.

12" Jack Pine (S 26) (NBT) N 51° E 45½ lks.

AND

DESCRIPTION IN DETAIL AS TO HOW CORNER WAS LOCATED AND IDENTIFIED OR RESTORED.

This corner was set from W. pine stump with axe mark (W. pine 6" S 67° W 21 lks) & 10' stub with axe mark and upper face found lying on ground (w. pine 7" N 60° E 7 lks). Both in proper distance and bearing .

Line ties -

Corner lies 1.14 chs. east of 79.50 chs. from north.

SURVEYOR'S SEAL

SIGNED Billy D. Buckler DATE 12/30/66
REGISTERED LAND SURVEYOR