

MICHIGAN
DEPARTMENT OF CONSERVATION
FORESTRY DIVISION

LAND CORNER RECORD

T. 45N N. R. 27W


Marquette COUNTY

DESCRIPTION OF CORNER Sec. Cor. common to 23-24-25-26

CORNER MONUMENT 1" Pipe with 4" Alum. Cap.

DATE MONUMENT PLACED AND WITNESSED 5/23/66, Billy D. Buckler

WITNESSES TO CORNER..... 14" Jack Pine (S 26 NBT) S 5° W 25.7'

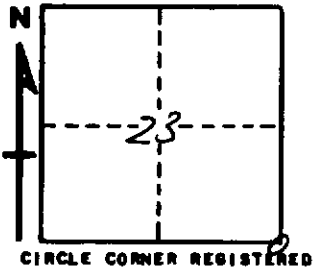

9" Jack Pine (S 23 NBT) N 32° W 39.8'

AND

DESCRIPTION IN DETAIL AS TO HOW CORNER WAS LOCATED AND IDENTIFIED OR RESTORED.

This corner replaced from one original bearing tree, a burned stump with bottom face with scribe marks in evidence, bearing N 9° E 25 lks.

Cor. lies 1.88 chs. south and .95 chs. west of Horseshoe Lake.

North edge of cabin approx. 500' distance bears N88°E.

SURVEYOR'S SEAL

SIGNED Billy D. Buckler
REGISTERED LAND SURVEYOR DATE 12/30/66