

MICHIGAN
DEPARTMENT OF CONSERVATION
FORESTRY DIVISION

LAND CORNER RECORD

T. 45N N.R. 27W


Marquette COUNTY

DESCRIPTION OF CORNER 1/2 corner bet. Secs. 3-4

CORNER MONUMENT 1" pipe with 4" aluminum cap.

DATE MONUMENT PLACED AND WITNESSED 10/19/66

WITNESSES TO CORNER..... 10" Red Oak (1/2 S 3/4 NBT) S39°W 21.4'

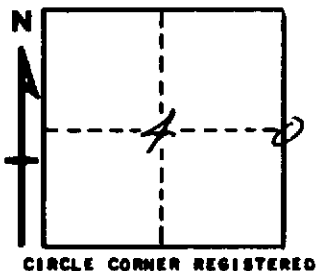

16" Red Pine (1/2 S NBT) N15°E 55.7'

AND

DESCRIPTION IN DETAIL AS TO HOW CORNER WAS LOCATED AND IDENTIFIED OR RESTORED.

Squared and scribed 7" red oak. 4.5' east of corner.

This corner re-established on line and by proportionate measure between section corners.

SURVEYOR'S SEAL

SIGNED Billy D. Buckler DATE 1/11/67
REGISTERED LAND SURVEYOR