

MICHIGAN
DEPARTMENT OF CONSERVATION
FORESTRY DIVISION

LAND CORNER RECORD

T. 45N N.R. 27W


Marquette COUNTY

DESCRIPTION OF CORNER Corner Record: 1/4 corner bet. Secs. 31-32

CORNER MONUMENT 1" pipe with 4" aluminum cap.

DATE MONUMENT PLACED AND WITNESSED 7/19/66

WITNESSES TO CORNER..... 12" W. Birch (1/2 S NBT) N47°W 6.8'

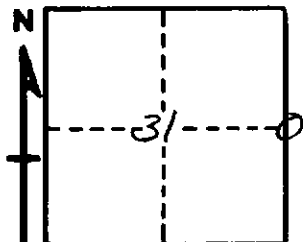

6" hard maple (1/2 S NBT) S40°E 31.6'

AND

CIRCLE CORNER REGISTERED

DESCRIPTION IN DETAIL AS TO HOW CORNER WAS LOCATED AND IDENTIFIED OR RESTORED.

This corner re-established midway and on line bet. two sec. cors.

Found no evidence of the original corner.

Corner lies on side hill, facing north-east and 2.00 chs. west of road.

SURVEYOR'S SEAL

SIGNED Billy D. Buckler
Billy D. Buckler
REGISTERED LAND SURVEYOR

DATE 1/9/67