

✓

**MICHIGAN  
DEPARTMENT OF CONSERVATION  
FORESTRY DIVISION**

# LAND CORNER RECORD

T. 45N N.R. 27W


Marquette COUNTY

DESCRIPTION OF CORNER 1/2 cor. bet. Secs. 28-29

CORNER MONUMENT 1" pipe with 4" aluminum cap.

DATE MONUMENT PLACED AND WITNESSED 8/3/66

WITNESSES TO CORNER..... 10" B. Spruce (1/2 S NBT) S16°W 10.8'

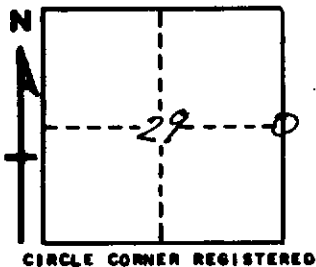

8" W. Birch (1/2 S NBT) East 18.2'

AND

**DESCRIPTION IN DETAIL AS TO HOW CORNER WAS LOCATED AND IDENTIFIED OR RESTORED.**

This corner re-established midway and on line bet. two sec. cors.

Found evidence of the original corner.

**SURVEYOR'S SEAL**

*Billy D. Buckler*

SIGNED Billy D. Buckler DATE 1/9/67  
REGISTERED LAND SURVEYOR