

MICHIGAN
DEPARTMENT OF CONSERVATION
FORESTRY DIVISION

LAND CORNER RECORD

T. 45N N.R. 27W


Marquette COUNTY

DESCRIPTION OF CORNER Sec. Cor. common to Secs. 20-21-28-29

CORNER MONUMENT 1" pipe with 4" aluminum cap

DATE MONUMENT PLACED AND WITNESSED 8/3/66

WITNESSES TO CORNER..... 20" red pine (S20 NBT) N26°W 80.5'

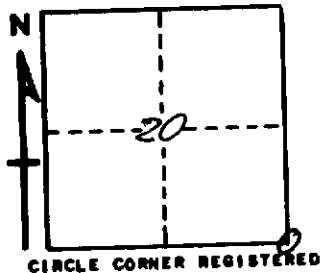

6" Soft maple (S28 NBT) S58°W 11.6'

AND

DESCRIPTION IN DETAIL AS TO HOW CORNER WAS LOCATED AND IDENTIFIED OR RESTORED.

This corner re-established midway bet. sec. corners; 1 mile north and 1 mile south.

Found no evidence of the original corner. Distance to streams north and south check well.

SURVEYOR'S SEAL

SIGNED Billy D. Buckler
Billy D. Buckler
REGISTERED LAND SURVEYOR

DATE 1/9/67