

MICHIGAN
DEPARTMENT OF CONSERVATION
FORESTRY DIVISION

LAND CORNER RECORD

T. 45N R. 27W


Marquette COUNTY

DESCRIPTION OF CORNER Corner Record: $\frac{1}{4}$ Cor. bet. Secs. 19-20

CORNER MONUMENT 1" pipe with 4" aluminum cap.

DATE MONUMENT PLACED AND WITNESSED 8/4/66

WITNESSES TO CORNER..... 12" Jack Pine ($\frac{1}{4}$ S NBT) S85°E 18.0'

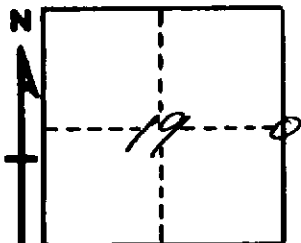

5" Jack Pine ($\frac{1}{4}$ S NBT) North 1.3'

AND

CIRCLE CORNER REGISTERED

DESCRIPTION IN DETAIL AS TO HOW CORNER WAS LOCATED AND IDENTIFIED OR RESTORED.

This corner re-established midway and on line bet. two sec. cors.

No evidence of original cor.

SURVEYOR'S SEAL

SIGNED Billy D. Buckler DATE 1/10/67
REGISTERED LAND SURVEYOR