

MICHIGAN  
DEPARTMENT OF CONSERVATION  
FORESTRY DIVISION

LAND CORNER RECORD

T. 45N N.R. 27W

Marquette COUNTY


DESCRIPTION OF CORNER 1/4 Corner bet. Secs. 26-27

CORNER MONUMENT 1" pipe with 4" aluminum cap.

DATE MONUMENT PLACED AND WITNESSED 9/2/66

WITNESSES TO CORNER..... 9" Soft Maple (1/8 S NBT) N58°E 17.7'

9" Hard Maple (1/8 S NBT) S21°W 53.0'

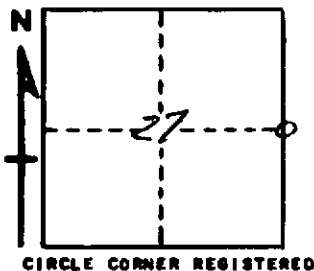

AND

DESCRIPTION IN DETAIL AS TO HOW CORNER WAS LOCATED AND IDENTIFIED OR RESTORED.

This corner re-established midway and on line bet. two sec.  
cors.

No evidence of original cor.

SURVEYOR'S SEAL

SIGNED Billy D. Buckler DATE 1/11/67  
Billy D. Buckler  
REGISTERED LAND SURVEYOR