

MICHIGAN
DEPARTMENT OF CONSERVATION
FORESTRY DIVISION

LAND CORNER RECORD

T. 45N N.R. 27W


Marquette COUNTY

DESCRIPTION OF CORNER 1/4 Corner bet. Secs. 2-3

CORNER MONUMENT 1" pipe with 4" aluminum cap.

DATE MONUMENT PLACED AND WITNESSED 9/12/66

WITNESSES TO CORNER..... 16" Red Pine (1/4 S NBT) N73°E 77.0'

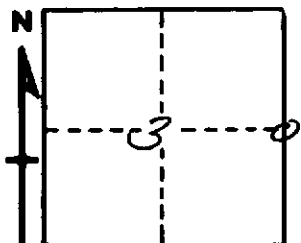

9" Red Oak (1/4 S NBT) N22°W 30.8'

9" Red Oak (1/4 S NBT) S23°E 34.3'

AND

CIRCLE CORNER REGISTERED

DESCRIPTION IN DETAIL AS TO HOW CORNER WAS LOCATED AND IDENTIFIED OR RESTORED.

This corner replaced from one w.pine B.T.; a stub bearing N73°W, 38 lks. Stub is down both faces in evidence in poor condition and a y. pine stump, bearing S40°E, 42 lks.; stump badly burned with no remaining marks.

Found granite boulder 3.02 chs. south and 63 lks. east as indicated in original notes.

Corner lies on top of ridge bearing NW SE.

SURVEYOR'S SEAL

SIGNED Billy D. Buckler DATE 1/11/67
BILLY D. BUCKLER
REGISTERED LAND SURVEYOR