

MICHIGAN
DEPARTMENT OF CONSERVATION
FORESTRY DIVISION

LAND CORNER RECORD

T. 45N N.R. 27W


Marquette COUNTY

DESCRIPTION OF CORNER Sec. Cor. common to Secs. 11-12-13-14

CORNER MONUMENT 1" pipe with 4" aluminum cap.

DATE MONUMENT PLACED AND WITNESSED 10/12/66

WITNESSES TO CORNER..... 11" Hard Maple (S13 NBT) S2°E 14.5'

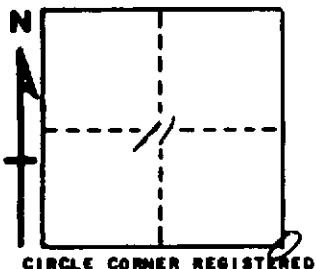

7" Hard Maple (S12 NBT) N60°E 22.3'

5" Hard Maple (S11 NBT) N37°W 29.5'

AND

DESCRIPTION IN DETAIL AS TO HOW CORNER WAS LOCATED AND IDENTIFIED OR RESTORED.

This corner re-established by double proportionate measure to corners;
1 mile north; $\frac{1}{2}$ mile east; $\frac{1}{2}$ mile south and 1 mile west.

Found no evidence of original corner.

SURVEYOR'S SEAL

Billy D. Buckler
SIGNED Billy D. Buckler DATE 1/11/67
REGISTERED LAND SURVEYOR