

MICHIGAN  
DEPARTMENT OF CONSERVATION  
FORESTRY DIVISION

LAND CORNER RECORD

T. 45N N.R. 27W


Marquette COUNTY

DESCRIPTION OF CORNER Sec. Cor. common to Secs. 10-11-14-15

CORNER MONUMENT 1" pipe with 4" aluminum cap.

DATE MONUMENT PLACED AND WITNESSED 8/19/66

WITNESSES TO CORNER..... 11" Red Oak (S10 NBT) N4<sup>o</sup>W 51.6'

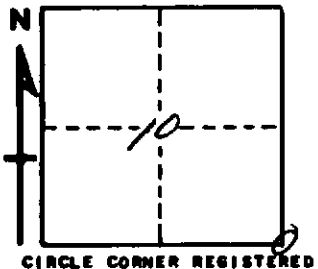

9" Red Oak (S15 NBT) S21<sup>o</sup>W 23.0'

AND

DESCRIPTION IN DETAIL AS TO HOW CORNER WAS LOCATED AND IDENTIFIED OR RESTORED.

This corner replaced at wood post set by unknown surveyor. Found w. pine stump bearing S9<sup>o</sup>W 25 lks. for probable witness tree.

SURVEYOR'S SEAL

SIGNED Billy D. Buckler  
Billy D. Buckler  
REGISTERED LAND SURVEYOR

DATE 1/11/67