

MICHIGAN
DEPARTMENT OF CONSERVATION
FORESTRY DIVISION

LAND CORNER RECORD

T. 45N N. R. 27W


Marquette COUNTY

DESCRIPTION OF CORNER 1/4 Corner bet. Secs. 15-22

CORNER MONUMENT 1" pipe with 4" aluminum cap.

DATE MONUMENT PLACED AND WITNESSED 9/7/66

WITNESSES TO CORNER..... 15" Twin Cedar (1/2 S NBT) N30°E 44.6'

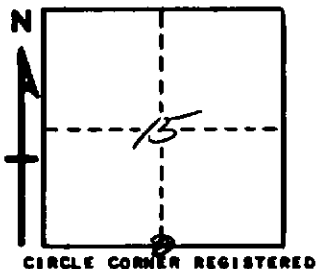

16" Cedar (1/2 S NBT) N4°W 31.8'

AND

DESCRIPTION IN DETAIL AS TO HOW CORNER WAS LOCATED AND IDENTIFIED OR RESTORED.

This corner re-established by proportionate measure between two Section corners.
Found no evidence of the original corner.

Corner lies on north margin of small stream, in a Beaver Dam.

SURVEYOR'S SEAL

SIGNED Billy D. Buckler DATE 1/11/67
Billy D. Buckler
REGISTERED LAND SURVEYOR