

LAND CORNER RECORDATION CERTIFICATE
Filing Requirement of Act 74, Mich. P.A. 1970

For corners in

<u>Marquette</u> (County)	Located In:	Corner Code #
1. Public Land Survey	T ___ R ___	_____
	T ___ R ___	_____
	T ___ R ___	_____
	T ___ R ___	_____
2. Property Controlling in Section	S <u>36</u> T <u>45N</u> R <u>29W</u>	<u>2</u>
	S <u>36</u> T <u>45N</u> R <u>29W</u>	<u>5</u>
3. Miscellaneous Property in Sec.	S ___ T ___ R ___	_____
	S ___ T ___ R ___	_____

Register of Deeds Stamp & File Number

4. Lot No. _____, Recorded Plat _____
 5. Private Claims _____

5 Dec 09 2002
 2 Dec 10 2002

I, Stephan J. Szyszkoski, in a field survey on _____, 20__ do hereby state that under requirements of P.A. 74, Michigan P.A. of 1970, the corner points mentioned in lines 1 and 2 above were in conformance with regulations and rules therefore as required in the current manual of survey instructions of the United States Department of the Interior, Bureau of Land Management or by a decree of a Court of Law and /or that the corner points mentioned in lines 3, 4 and 5 above were in conformance with the rules of the Michigan Board of Land Surveyors or by a Decree of a Court of Law; established, re-established, monumented, recovered, found as expressed below:


NOTE: Not more than 2 corners, all in the same town and range, may be recorded on this certificate.

A	B	C	D	E	F	G	H	I	J	K	L	M
1												
2	6		5		4		3		2		1	
3												
4	7		8		9		10		11		12	
5												
6	18		17		16		15		14		13	
7												
8	19		20		21		22		23		24	
9												
10	30		29		28		27		26		25	
11												
12	31		32		33		34		35		36	
13												

A. Description of original monument and accessories and/or subsequent restoration:
 (2-Sec. 36) East 1/16 corner between Sections 25-36. Not established in the original survey.
 (5-Sec. 36) North 1/16 corner, Section 36. Not established in the original survey.

B. Description of corner evidence found and/or method applied in restoring or reestablishing corner:
 (2-Sec. 36) Established the corner midway and on a line of mean true bearing between Section corner 1315.90' east and Quarter corner 1315.90' west. From the position thus established, I found an iron pin set by an unknown party S05W 13.4' distant.
 (5-Sec. 36) Established the corner midway and on a straight line between Center of Section 1323.40' south and Quarter corner 1323.40' north. From the position thus established, I found an iron pin set by an unknown party N72W, 18' distant.

C. Description of monument for corner and accessories established to perpetuate locating the position of the corner:
 (2) Set 1"IDx32" I.pipe with 4" alum. M.D.N.R. cap. Blazed, scribed, and set measuring nails in:
 4" B.Spruce N43E 73.17' "1/16S BT"
 20" R.Pine S50E 62.92' do
 25" R.Pine S04W 124.94' do
 12" Cedar N56W 86.88' do
 Set sq'd spruce post adjacent. Bearings are magnetic. Distances are to nail with tag.
 (5) Set 1"IDx32" I.pipe with 4" alum. M.D.N.R. cap. Blazed, scribed, and set measuring nails in:
 18" Spruce N66E 35.81' "1/16S BT"
 15" Spruce S04E 52.70' do
 5" Spruce N79W 38.91' do
 5" Spruce N21W 44.53' do
 Set sq'd spruce post adjacent. Bearings are magnetic. Distances are to nail with tag.

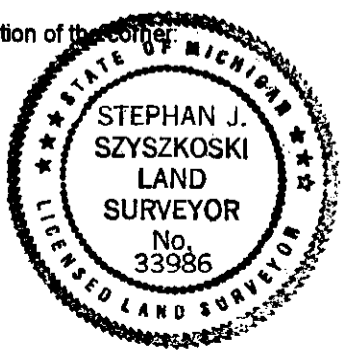

Signed by Stephan J. Szyszkoski
 Surveyor's Michigan License No. 33986

Date 12/19/02