

LAND CORNER RECORDATION CERTIFICATE
Filing Requirement of Act 74, Mich. P.A. 1970

For corners in

<u>Marquette</u> (County)	Located In:	Corner Code #
1. Public Land Survey	T <u>45N</u> R <u>29W</u>	<u>L13</u>
	T ___ R ___	_____
	T ___ R ___	_____
	T ___ R ___	_____
2. Property Controlling in Section	S <u>36</u> T <u>45N</u> R <u>29W</u>	<u>16</u>
	S ___ T ___ R ___	_____
3. Miscellaneous Property in Sec.	S ___ T ___ R ___	_____
	S ___ T ___ R ___	_____

Register of Deeds Stamp & File Number

4. Lot No. _____, Recorded Plat _____
 5. Private Claims _____

16 Dec 10 2002
 L13 Dec 12 2002

I, Stephan J. Szyszkoski, in a field survey on _____, 20__ do hereby state that under requirements of P.A. 74, Michigan P.A. of 1970, the corner points mentioned in lines 1 and 2 above were in conformance with regulations and rules therefore as required in the current manual of survey instructions of the United States Department of the Interior, Bureau of Land Management or by a decree of a Court of Law and /or that the corner points mentioned in lines 3, 4 and 5 above were in conformance with the rules of the Michigan Board of Land Surveyors or by a Decree of a Court of Law; established, re-established, monumented, recovered, found as expressed below:

NOTE: Not more than 2 corners, all in the same town and range, may be recorded on this certificate.

1	A	B	C	D	E	F	G	H	I	J	K	L	M
2		6		5		4		3		2		1	
3													
4		7		8		9		10		11		12	
5													
6		10		17		16		15		14		13	
7													
8		19		20		21		22		23		24	
9													
10		30		29		28		27		26		25	
11													
12		31		32		33		34		35		36	
13													

A. Description of original monument and accessories and/or subsequent restoration:


(L13) Quarter corner common to Section 36 T45N-R29W and Section 1 T44N-R29W. 1959 - Reestablished by Billy D. Buckler RLS: Re-established midway and on line between two sec. cors. Found no evidence of original cor. Found old blazes to east in line with cors. Cor. placed and wit. 4/20/59 with C.Schooley, D.F. and Neal Spherhake, Marquette. 1" pipe with 4" brass cap. 5" R.Pine S01W 35 links, 6" R.Pine N14W 114 links.
 (16-Sec. 36) East 1/16 corner between Section 36 T45N-R29W and Section 1 T44N-R29W. Not established in the original survey.

B. Description of corner evidence found and/or method applied in restoring or reestablishing corner:

(L13) Found the 1959 monument in good condition and at record bearing and distance from Mr. Buckler's accessories. My measurements show that this monument is located N 89 deg. 31'W (true brg.) 8.46' from the proportionate position intended in 1959 (0.11' south of a straight line between corners). Mr. Buckler reestablished M13 by proportionate measurement, using K13 and B13(T44N-R29W). The easting of the Township corner M13 checks very well (0.4' east) against its E-W proportionate position between K13 and B13 as I calculate it. So, I conclude that Mr. Buckler measured well between K13 and B13 and that the error in position found in this monument was caused by him having made a chaining error in laying it out from a point on his random line. It does not appear as though anyone has relied upon it in the intervening years and so I destroyed the 1959 corner and reestablished L13 midway and on a line of mean true bearing between Section corner 2652.05' west and Township corner 2652.05' east, being the position intended in 1959.
 (16-Sec. 36) Established the corner midway and on a line of mean true bearing between Quarter corner 1326.02' west and Township corner 1326.02' east.

C. Description of monument for corner and accessories established to perpetuate locating the position of the corner:

(L13) Set 1"IDx32" I.pipe with 4" alum. MDNR cap. Blazed, scribed, and set measuring nails in: 21" R.Pine N16W 77.85' old blazes * 13" R.Pine S22W 24.00 do * 7" R.Pine S88E 38.08' "1/14S N8T" 12" R.Pine S81W 29.03' do A treated 4x4 post adjacent. Bearings are magnetic. Distances to nail with tag. * denotes new measurement to BDB 1959 witness.	(16) Set 1"IDx32" I.pipe with 4" alum. MDNR cap. Blazed, scribed, and set measuring nails in: 5" Poplar N59E 18.65' "1/16S BT" 6" W.Spruce S61E 83.15' do 20" R.Pine S70W 48.8' do 10" R.Maple N78W 21.85' do Set sq'd cedar post adjacent. Bearings are magnetic. Distances are to nail with tag.
---	---

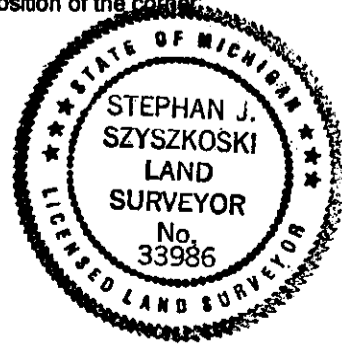

Signed by Stephan J. Szyszkoski
 Surveyor's Michigan License No. 33986

Date 12/19/02