

**LAND CORNER RECORDATION CERTIFICATE**  
**Filing Requirement of Act 74, Mich. P.A. 1970**

For corners in

<u>Marquette</u> (County)	Located In:	Corner Code #
1. Public Land Survey	T 45N R 29W	M12
	T 45N R 29W	L11
	T R	
	T R	
2. Property Controlling in Section	S T R	
	S T R	
3. Miscellaneous Property in Sec.	S T R	
	S T R	

Register of Deeds Stamp & File Number

4. Lot No. \_\_\_\_\_, Recorded Plat \_\_\_\_\_  
 5. Private Claims \_\_\_\_\_

L11 Dec 09 2002  
 M12 Nov 21 2002

I, Stephan J. Szyszkoski, in a field survey on \_\_\_\_\_, 20\_\_\_\_ do hereby state that under requirements of P.A. 74, Michigan P.A. of 1970, the corner points mentioned in lines 1 and 2 above were in conformance with regulations and rules therefore as required in the current manual of survey instructions of the United States Department of the Interior, Bureau of Land Management or by a decree of a Court of Law and/or that the corner points mentioned in lines 3, 4 and 5 above were in conformance with the rules of the Michigan Board of Land Surveyors or by a Decree of a Court of Law; established, re-established, monumented, recovered, found as expressed below:

NOTE: Not more than 2 corners, all in the same town and range, may be recorded on this certificate.

	A	B	C	D	E	F	G	H	I	J	K	L	M
1													
2	6		5		4		3		2		1		
3													
4	7		8		9		10		11		12		
5													
6	10		17		16		15		14		13		
7													
8	19		20		21		22		23		24		
9													
10	30		29		28		27		26		25		
11													
12	31		32		33		34		35		36		
13													

A. Description of original monument and accessories and/or subsequent restoration:  
 (M12) Quarter corner common to Section 36 T45N-R29W and Section 31 T45N-R28W. 1846 - Established by Wm. A. Burt: North on east side of Section 36...40.00 Set W.Birch post qr. section cor. W.Birch 7 N78E 18, W.Birch 6 S50W 15...80.00 Set sugar post corner of Sections 25 and 36.

(L11) Quarter corner common to Sections 25-36. 1848 - Established by Wells Burt: West corrected between 25 and 36...39.94 Set W.Pine post qr. sect. cor., W.Pine 32 N69W 7, Spruce 6 S81E 21...79.88 Section corner. 1956 - Notes by B.D.Buckler RLS show "monument set by unknown party. Believe this mon. set in error". The monument was found 1.12 chains south of his random line. The random was approx. 2 links south of a line between Section corners at this point. He found the monument to be 2622.8' east of the Section corner. Mr. Buckler did not monument this corner.

B. Description of corner evidence found and/or method applied in restoring or reestablishing corner:

(M12) The original post and accessories were not recovered. Found no evidence of the position of the original corner on the ground. Reestablished the corner midway and on a straight line between Section corners 2638.56' north and south.

(L11) The original post and accessories were not recovered. Found the monument noted by Mr. Buckler, it being a 1.5" ID I.pipe with 3.25" dia. brass cap, projecting 20" above ground. The monument is now located very nearly on Mr. Buckler's random line about 75' north and about 8' west of its position in 1956. This fact suggests that someone has moved it during the intervening years. It is now located 19.56' west of proportioned GLO position between the Section corners. I did not accept this monument as marking the position of the corner. Established the corner midway and on a line of mean true bearing between Section corners 2631.79' east and west.

C. Description of monument for corner and accessories established to perpetuate locating the position of the corner:

(M12) Set 1"IDx32" I.pipe with 4" alum. MDNR cap. Blazed, scribed, and set measuring nails in:


6" Oak N09E 19.7' "1/4S NBT"  
 6" twin R.Maple N82E 30.35' do  
 8" R.Pine S14W 15.8' do  
 8" J.Pine S86W 38.1' do

Set sq'd spruce post adjacent. Bearings are magnetic. Distances are to nail with tag.

(L11) Set 1"IDx32" I.pipe with 4" alum. MDNR cap. Blazed, scribed, and set measuring nails in:

7" Spruce N21E 15.48' "1/4S NBT"  
 7" Spruce S50E 22.08' do  
 6" Spruce S32W 38.50' do  
 4" Spruce N60W 29.70' do

Set sq'd spruce post adjacent. Bearings are magnetic. Distances are to nail with tag.

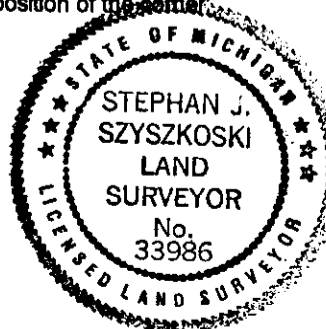

Signed by Stephan J. Szyszkoski  
 Surveyor's Michigan License No. 33986

Date 12/19/02