LAND CORNER RECORDATION CERTIFICATE
Filing Requirement of Act 74, Mich. P.A. 1970 as Amended

For corners in

Marquette (County)

		Located In:		Corner Code #
1. Public Land Survey		T 45N	R 29W	K3
		T	R	
		T	R	
	S	T	R	
2. Property Controlling	S 2	T 45N	R 29W	2
in Section	S	T	R	
3. Miscellaneous	S	T	R	
Property in Sec.	S	T	R	

Register of Deeds Stamp & File Number

4. Lot No. _____ , Recorded Plat_____

5. Private Claims

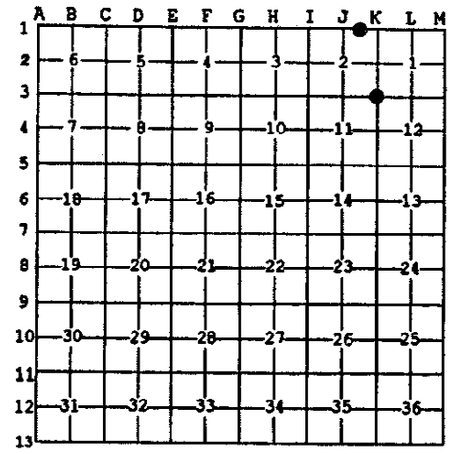

Aug 09 2004

I, Stephan J. Szyszkoski, in a field survey on _____, 20 ____ do hereby state that under requirements of P.A. 74, Michigan P.A. of 1970, the corner points mentioned in lines 1 and 2 above were in conformance with regulations and rules therefore as required in the current manual of survey instructions of the United States Department of the Interior, Bureau of Land Management or by a decree of a Court of Law and /or that the corner points mentioned in lines 3, 4 and 5 above were in conformance with the rules of the Michigan Board of Land Surveyors or by a Decree of a Court of Law; established, re-established, monumented, recovered, found as expressed below:

NOTE: Not more than 2 corners, all in the same town and range, may be recorded on this certificate.

A. Description of original monument and accessories and/or subsequent restoration:

(K3) Corner common to Sections 1-2-11-12. 1959 - Billy D. Buckler, RLS remonumented the corner at record bearing and distance from two W.Pine stumps described as being the probable BTs, in poor condition. Set 1" Iron pipe with 4" brass cap. 18" R.Pine stump S50W 53 links, 28" W.Pine stub N69W 103 links, 13" twin R.Pine N09E 237 links.
(2-Sec. 2) East 1/16 corner between Sections 2 T45N-R29W and 35 T46N-R29W. Not established in the original survey.

B. Description of corner evidence found and/or method applied in restoring or reestablishing corner:

(K3) Recovered the 1959 monument in good condition, firmly set, projecting 1.6' a.g. at the intersection of fencelines running south and east, and at record bearing and distance from the remaining 1959 witness R.Pine stump S50W 53 links. The other 1959 witnesses were not recovered. Left the monument in place and made new witnesses as described below.
(2-Sec. 2) Established the corner on the curved township line 1322.98' East of the Quarter corner common to Sections 2 & 35 and 1322.98' West of the Section corner common to Sections 1-2 T45N-R29W and 35-36 T46N-R29W.

C. Description of monument for corner and accessories established to perpetuate locating the position of the corner:

(K3) Found 1"ID I.pipe with 4" brass MI Dept. of Conservation cap. Blazed, scribed, and set meas. nails in:

6" J.Pine S43W 62.7'	"S11 NBT"
9" J.Pine N86W 54.3'	"S2 NBT"
6" Poplar N51W 38.9'	do
9" Poplar N09E 35.4'	"S1 NBT"

Set sq'd J.Pine post adjacent. Bearings are magnetic. Distances are to nail with tag.

(2) Set 1"IDx32" I.pipe with 4" alum. MDNR cap. Blazed, scribed, and set measuring nails in:

10" R.Pine N52E 27.5'	"1/16S BT"
5" R.Pine S55E 18.1'	do
4" Oak S19W 20.9'	do
8" Maple N80W 13.8'	do

A 4"x4" treated wood post is adjacent. Bearings are magnetic. Distances are to nail with tag.

STATE OF MICHIGAN
STEPHAN J. SZYSZKOSKI
LAND SURVEYOR
No. 33986
LICENSED LAND SURVEYOR

Signed by Stephan J. Szyszkoski Date 9/2/04

Surveyor's Michigan License No. 33986

For the Michigan Department of Natural Resources, Office of Land and Facilities

FORM APPROVED BY MICHIGAN STATE BOARD OF PROFESSIONAL SURVEYORS, JAN. 28, 1971
Revised May 14, 1975
Revised Jan., 1983
Revised Oct., 1995