

MARQUETTE COUNTY
MICHIGAN
RECEIVED FOR RECORD

1993 AUG 26 PM 3:02

LAND CORNER RECORDATION CERTIFICATE
Filing Requirement of Act 74, Mich. P.A. 1970

Patricia A. Moulton
REGISTERED PROFESSIONAL L.S.

For corners in

Marquette
(County)

Located In: Corner Code: #/

- 1. Public Land Survey T R
- 2. Property Controlling in Section S 15 T 46N R 25W 1,3,4
- 3. Miscellaneous Property in Sec. S T R
- 4. Lot No. _____, Recorded Plat _____
- 5. Private Claims _____

Liber 5 R.C. Page 380

Register of Deeds Stamp & File Number

I, Paul Bressette, in a field survey on June 22, 19 93, do hereby certify that under requirements of P.A. 74, Michigan P.A. of 1970, the corner points mentioned in lines 1 and 2 above were in conformance with regulations and rules therefore as required in the current manual of survey instructions of the United States Department of the Interior, Bureau of Land Management or by a decree of a Court of Law and/or that the corner points mentioned in lines 3, 4 and 5 above were in conformance with the rules of the Michigan Board of Land Surveyors or by a Decree of a Court of Law; established, re-established, monumented, re-monumented, recovered, found as expressed below:


A	B	C	D	E	F	G	H	I	J	K	L	M
2	6	5	4	3	2	1						
3												
4	7	8	9	10	11	12						
5												
6	18	17	16	15	14	13						
7												
8	19	20	21	22	23	24						
9												
10	30	29	28	27	26	25						
11												
12	31	32	33	34	35	36						
13												

NOTE: Not more than 4 corners, all in the same town and range, may be recorded on this certificate.

- A. Description of original monument and accessories and/or subsequent restoration:
- 1 West One-sixteenth corner common to Sections 10 and 15. Found 1 1/2" iron pipe, origin unknown.
 - 3 North One-sixteenth corner common to Sections 15 and 16. Not set in original survey, no evidence of subsequent establishment.
 - 4 Northwest One-sixteenth corner of Section 15. Found 1" iron pipe, origin unknown.

- B. Description of corner evidence found and/or method applied in restoring or reestablishing corner:
- 1 Rejected found iron pipe as it falls 53.43 feet from calculated position. Corner position established mid-point and on-line between the Northwest and North Quarter corners of Section 15.
 - 3 Corner position established mid-point and on-line between the Northwest and West Quarter corners of Section 15.
 - 4 Rejected found iron pipe as it falls 21.65 feet from calculated position. Corner position established at the intersection of the North and West one-sixteenth lines.

- C. Description of monument for corner and accessories established to perpetuate locating the position of the corner:
- | | | |
|-------------------------|-------------------------|-------------------------|
| 1 DNR Mon. | 3 DNR Mon. | 4 DNR Mon. |
| 10" J. Pine N01°E 38.8' | 6" J. Pine S65°E 59.4' | 5" J. Pine N76°E 13.25' |
| 7" J. Pine N48°E 26.7' | 6" J. Pine S60°W 51.45' | 9" J. Pine S52°E 40.55' |
| 7" J. Pine S17°E 40.55' | 7" J. Pine N70°W 37.7' | 8" J. Pine S16°W 22.7' |
| 8" J. Pine S25°W 5.9' | 5" J. Pine N08°W 45.2' | 5" J. Pine S49°W 32.25' |

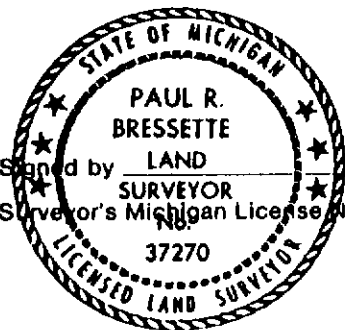

Signed by Paul R. Bressette Date 8-25-93

Surveyor's Michigan License No. 37270