

26

MARQUETTE COUNTY
MICHIGAN
RECEIVED FOR RECORD

1993 AUG 26 PM 3:02

Patricia A. Meehan
REGISTER OF DEEDS

LAND CORNER RECORDATION CERTIFICATE
Filing Requirement of Act 74, Mich. P.A. 1970

For corners in

Marquette
(County)

Located In: Corner Code -//

- 1. Public Land Survey T 46N R 25W H=7, I=6, I=7
T R
T R
T R
- 2. Property Controlling S T R
in Section S T R
- 3. Miscellaneous S T R
Property in Sec. S T R
- 4. Lot No. _____, Recorded Plat
- 5. Private Claims

Liber 5 R.C. Page 379

Register of Deeds Stamp & File Number

	A	B	C	D	E	F	G	H	I	J	K	L	M
2	6		5		4		3		2		1		
3													
4	7		8		9		10		11		12		
5													
6	18		17		16		15		14		13		
7													
8	19		20		21		22		23		24		
9													
10	30		29		28		27		26		25		
11													
12	31		32		33		34		35		36		
13													

I, Paul Bressette in a field survey on June 29, 1993
do hereby certify that under requirements of P.A. 74, Michigan P.A. of 1970, the corner points mentioned in lines 1 and 2 above were in conformance with regulations and rules therefore as required in the current manual of survey instructions of the United States Department of the Interior, Bureau of Land Management or by a decree of a Court of Law and/or that the corner points mentioned in lines 3, 4 and 5 above were in conformance with the rules of the Michigan Board of Land Surveyors or by a Decree of a Court of Law; established, re-established, monumented, re-monumented, recovered, found as expressed below:

NOTE: Not more than 4 corners, all in the same town and range, may be recorded on this certificate.

A. Description of original monument and accessories and/or subsequent restoration:

- H-7 Quarter corner common to Sections 15 and 22. Marquette County Road Commission Fieldbook No. 712. 1" iron pipe, witnessed by 6" J. Pine S28°W 55.6', 4" J. Pine N20°W 40.8'.
- I-6 Quarter corner common to Sections 14 & 15. Marquette County Road Commission Fieldbook No. 712. 1" iron pipe about 35' east of Co. Rd. 553. Near Contois house. No witnesses given.
- I-7 Section corner common to Sections 14, 15, 22, and 23. Marquette County Road Commission Fieldbook No. 712. 1" iron pipe witnessed by: J. Pine 6" S81°W 48.9'; J. Pine 10" N48°E 72.7'.

B. Description of corner evidence found and/or method applied in restoring or reestablishing corner:


- H-7 Found iron pipe and SW bearing tree as described. All blazes on the BT have completely closed. Replaced pipe with a DNR monument and witnessed.
- I-6 Found 1" iron pipe and witnesses by a previous surveyor. Replaced iron pipe with DNR monument and witnessed. Corner falls 73.7 feet east of existing centerline of Co. Rd. 553.
- I-7 Found 1" iron pipe and SW bearing tree as described and witnesses by previous surveyor. SW bearing tree is now 12" in diameter, with blazes open showing scribing in butt blaze. Found nail with shiner in SW bearing tree and fence post to south. Replaced iron pipe with DNR monument and witnessed.

C. Description of monument for corner and accessories established to perpetuate locating the position of the corner:

H-7 DNR Mon.	I-6 DNR Mon.	I-7 DNR Mon.
9" J. Pine N06°E 39.55'	*8" J. Pine N17°E 32.46'	6" J. Pine N71°E 36.82'
7" J. Pine S83°E 26.35'	7" Red Maple N44°E 55.1'	8" J. Pine S27°W 47.19'
6" J. Pine S07°W 16.05'	NW Cor House S65°E 57.29'	11" J. Pine S87°W 32.34'
10" J. Pine N82°W 34.75'	*4" J. Pine S04°E 21.83'	10" J. Pine N27°W 75.39'

*Previous witnesses, measurement to double headed nail in side.

All of above are previous witnesses, measurements to double headed nail in side.

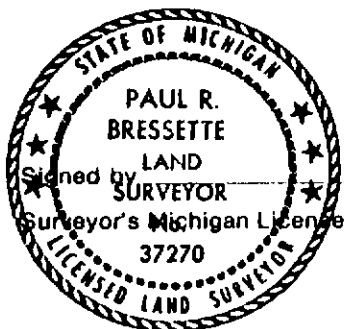

Paul R. Bressette Date 8-25-93

37270