

RE

2000

MARQUETTE COUNTY MICHIGAN RECEIVED FOR RECORD

1999 DEC 22 AM 11:25

Patricia A. Manley REGISTER OF DEEDS

SECTION

LAND CORNER RECORDATION CERTIFICATE Filing Requirement of Act 74, Mich. P.A. 1970

For corners in MARQUETTE (County) Located In: Corner Code # 1. Public Land Survey T 46N R 25W A-10 T 46N R 26W M-10 2. Property Controlling in Section S T R 3. Miscellaneous Property in Sec. S T R 4. Lot No. Recorded Plat 5. Private Claims

LIBER R2 PAGE 202 Register of Deeds Stamp & File Number

I, GERALD W. CARLSON, in a field survey on May 20, 1999, do hereby state that under requirements of P.A. 74, Michigan P.A. of 1970, the corner points mentioned in lines 1 and 2 above were in conformance with regulations and rules therefore as required in the current manual of survey instructions of the United States Department of the Interior, Bureau of Land Management or by a decree of a Court of Law and/or that the corner points mentioned in lines 3, 4 and 5 above were in conformance with the rules of the Michigan Board of Land Surveyors or by a Decree of a Court of Law; established, re-established, monumented, recovered, found as expressed below:

NOTE: Not more than 2 corners, all in the same town and range, may be recorded on this certificate.

A. Description of original monument and accessories and/or subsequent restoration: A-10: Corner common to Sections 30, T46N-R25W and 25 T46N-R26W.

1844: William A. Burt's original township boundary survey notes describe the corner monument as a wood post referenced by: 12" Spruce Pine S14W, 13L 12" Fir N85E, 16L

1990: A survey reference map by Sundberg, Carlson and Associates, Inc., indicates the corner. No description or references given.

1990: An LCRC by Keith Sackett, P.S.#19006, Liber 5 RC, Pg. 282, indicates he set a 1" inside diameter by 32" long iron pipe with a 4" aluminum cap midway and on line. No original monument or accessories found. He established the following references:

- 6" Maple N56E, 41.3' 1/4S NBT
6" Maple S85W, 22.5' 1/4S NBT
2" Maple S25E, 13.9' 1/4S NBT

B. Description of corner evidence found and/or method applied in restoring or reestablishing corner:

A-10: 1999: No original corner evidence found. Found and accepted a 1 1/4" outside diameter galvanized iron pipe with a 4" diameter aluminum tablet projecting 0.9' above ground. Checked Line Call: South, Granite Knob, 4 chains (264'), We measured 255' South and 105' West to hit South end of Easterly face of Granite knob. We also hit a small rock knob at 510' South and a Large rock knob at 660' South. Found a 6" Maple S82W, 22.74' to centerline (not healthy) Found a 3" Stump S30E, 14.30' to centerline Distance North is 2641.71', South is 2641.31'.

C. Description of monument for corner and accessories established to perpetuate locating the position of the corner:

A-10: 1999: Stamped the 1 1/4" outside diameter galvanized iron pipe with a 4" diameter aluminum tablet monument with: "MCR 1999". Monument is 0.9' above ground. Established new references:

- 6" Balsam S36W, 50.73' 6" Balsam S05W, 40.39'
6" Balsam N24W, 21.75' 6" Cherry S65W, 15.16'


Green Steel Sign Post w/ Yellow Survey Marker Sign N90W, 3.13'

Note: Bearing trees have painted face, butt, and side nail blazes, d.h. measuring nails, and stamped B.T. Tags affixed T46N-R25W Corner Search Report 99100

Grid table with columns A-M and rows 1-13. Cell 10,30 contains a black dot.

RATIFIED BY PEER GROUP P.A. 345 OF 1990

Larry J. Bussane DATE 10/25/99

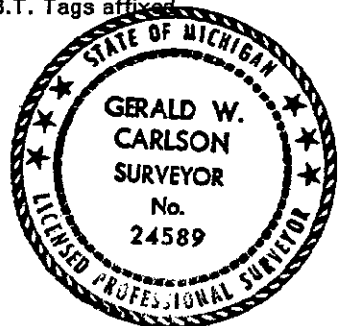

Signed by Gerald W. Carlson Date 12-8-99