

1994 DEC 28 PM 5:59

LAND CORNER RECORDATION CERTIFICATE
Filing Requirement of Act 74, Mich. P.A. 1970

Patricia L. Monahan
REGISTER OF DEEDS

LIBER 1 PAGE 199
Register of Deeds Stamp & File Number

JOB NUMBER: 94030
SHEET NO. : 1-533

4 corners in
MARQUETTE

(County)	Located in:	Corner Code=#
Public Land Survey	T 45N R 25W T 46N R 26W T 45N R 26W T 46N R 25W	A-1 M-13 M-1 A-13 ✓
Property Controlling in Section	S T R	
Miscellaneous	S T R	
Property in Sec.	S T R	

Lot No. _____, Recorded Plat _____
Private Claims _____

GERALD W. CARLSON, in a field survey on Tuesday, December 13, 1994, hereby certify that under requirements of P.A. 74, Michigan P.A. of 1970, the corner points mentioned in lines 1 and 2 above were in conformance with regulations and rules therefore as required in the current manual of survey instructions of the United States Department of the Interior, Bureau of Land Management or by a decree of a Court of Law and/or that the corner points mentioned in lines 3, 4 and 5 above were in conformance with the rules of the Michigan Board of Land Surveyors or by a Decree of a Court of Law; established, re-established, monumented, re-monumented, recovered, found as expressed below:

	A	B	C	D	E	F	G	H	I	J	K	L	M
2	6	5	4	3	2	1							
3													
4	7	8	9	10	11	12							
5													
6	18	17	16	15	14	13							
7													
8	19	20	21	22	23	24							
9													
10	30	29	28	27	26	25							
11													
12	31	32	33	34	35	36							
13													


NOTE: Not more than 4 corners, all in the same town and range, may be recorded on this certificate.

Description of original monument and accessories and/or subsequent restoration:
A-1; Section Corner common to Section 6, T45N-R25W; Section 1909: C. Cummings set corner from W. Pine B.T. stump, N52E, 31, T46N-R25W; Section 36, T46N-R26W; Section 1, T45N-R26W. 30 l. Distance east 5185', defl. 93-35', 206.7' south of 1844; William A. Burt's original survey notes describe the N.E. Corner set from stump of gov't Cedar B.T.. No monument or corner accessories given. (See reverse side.)
18" White Pine N52E, 30 l (See reverse side)
10" Spruce, S53W, 80 l

Description of corner evidence found and/or method applied in restoring or reestablishing corner:
1994- Found D.N.R. monument as set by P. Bressette. SCA distance east to NE Corner Section 6 is 5171.27' as compared to C. Cummings's distance in 1909 of 5172'. Accepted D.N.R. monument as the corner position.

RATIFIED BY PEER GROUP
P.A. 345 OF 1990
Larry J. Bassane
DATE Sept 26, 1994

Description of monument for corner and accessories established to perpetuate locating the position of the corner:
1994 - Found a 1 1/2" diameter iron with a 3 3/4" diameter cap stamped to identify the corner referenced by nails in:
16" White Pine N87W 4.05 ft. Bressette NBT
11" Cherry S02W 13.30 ft. Bressette NBT (tree is dying)
5" Balsam S37W 25.17 ft.
16" White Pine N03W 60.62 ft. Bressette NBT
11'ly Power line Tower S84E 45.84 ft. Bressette Accessory
Steel sign post N45W 2.10 ft.
Monument is 0.75' above ground and is near West edge of power line road. Stamped monument "MCR 1994" (Marquette County Remonumentation). Bk. 6, Pg. 141

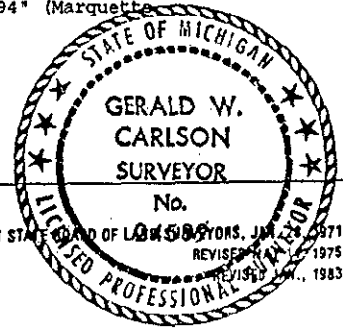

by Gerald W. Carlson Date 12-22-94
24589
Surveyor's Michigan License No. _____

Record No. 533

*Put
Geo
Ben*

Part "A" Continued:

1993: P. Bressette P.S. No. 37270: Found 1.5" iron pin used in survey of power line and in previous DNR surveys. Distance east to corner set from original evidence and also tied in by Cummings checks within 1.7 feet. Corner falls on west edge of power line clearing. Tower pole witness is stamped "18341" and "168R 30-85 1000." Distance is measured to face of pole. Witnesses:

W'ly tower pole	S83E	60.55'
11" Cherry	S03W	12.6'
17" W. Pine	N84W	3.35'
17" W. Pine	N01W	44.65'

L. 5 R.C. P. 382