

1994 DEC 28 PM 5:59

JOB NUMBER: 94030
SHEET NO.: 1-539

LAND CORNER RECORDATION CERTIFICATE
Filing Requirement of Act 74, Mich. P.A. 1970

For corners in


<u>MARQUETTE</u> (County)	Located In:	Corner Code #
1. Public Land Survey	T <u>45N</u> R <u>25W</u>	G-1
	T <u>46N</u> R <u>25W</u>	<u>G-13</u> ✓
	T _____ R _____	_____
	T _____ R _____	_____
2. Property Controlling in Section	S _____ T _____ R _____	_____
	S _____ T _____ R _____	_____
3. Miscellaneous Property in Sec.	S _____ T _____ R _____	_____
	S _____ T _____ R _____	_____

Patricia A. Monney
REGISTER OF DEEDS

LIBER 1 PAGE 205
Register of Deeds Stamp & File Number

4. Lot No. _____, Recorded Plat _____
5. Private Claims _____

I, GERALD W. CARLSON, in a field survey on Sunday, December 4, 1994, do hereby certify that under requirements of P.A. 74, Michigan P.A. of 1970, the corner points mentioned in lines 1 and 2 above were in conformance with regulations and rules therefore as required in the current manual of survey instructions of the United States Department of the Interior, Bureau of Land Management or by a decree of a Court of Law and/or that the corner points mentioned in lines 3, 4 and 5 above were in conformance with the rules of the Michigan Board of Land Surveyors or by a Decree of a Court of Law; established, re-established, monumented, re-monumented, recovered, found as expressed below:

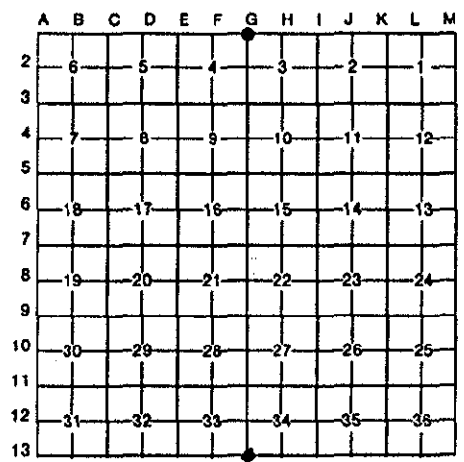

NOTE: Not more than 4 corners, all in the same town and range, may be recorded on this certificate.

A. Description of original monument and accessories and/or subsequent restoration:

G-1: Section Corner common to Sections 3 and 4, T45N-R25W and Sections 33 and 34, T46N-R25W. 1941: M.C.R.C. F.B. 712 indicates a set 1" iron pipe and a spruce post in swamp near the South edge of this swamp. 1844: William A. Burt's original survey notes describe the corner monument as a wood post referenced by:
9" Spruce Pine N65E, 35 1
4" Tamarack N14W, 22 1
This corner was set in accordance with U.S. field notes by running a line from the west and using distances noted: of stream, granite rocks in three places on line, course of stream on line, etc.. No corner accessories given.
1945: M.C.R.C. F.B. 697 indicates an iron pipe and post. No corner accessories given.


B. Description of corner evidence found and/or method applied in restoring or reestablishing corner:

1994- Found and accepted M.C.R.C. iron pipe as placed in 1941. Distance East is 2639.60' and distance West is 2611.12'.

RATIFIED BY PEER GROUP
P.A. 345 OF 1990
Larry J. Bussone
DATE Sept 26, 1994

C. Description of monument for corner and accessories established to perpetuate locating the position of the corner:

1994 - Replaced 1" diameter pipe with a 2 1/2" diameter aluminum pipe capped with a 3 1/4" diameter aluminum tablet Marquette County Survey Monument stamped to identify the corner referenced by nails in:
5" Black Spruce S80W 25.34 ft.
7" Jack Pine N13W 47.32 ft. GCVN NBT
5" Black Spruce N68E 12.50 ft. GCVN NBT
6" Black Spruce S26E 26.90 ft. GCVN NBT
Steel sign post North 2.0 ft.
Monument is 0.35' above ground and is in a low area 70' North of the treeline.
Bk. 6, Pg. 127

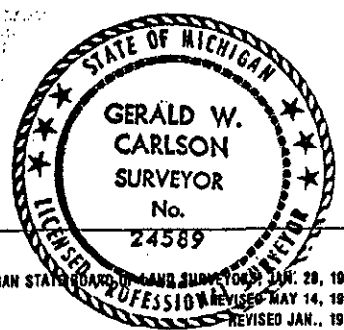

Signed by Gerald W. Carlson Date 12-22-94

Surveyor's Michigan License No. 24589