

# SURVEY & REMONUMENTATION

APR 28 1995

**LAND CORNER RECORDATION CERTIFICATE**  
Filing Requirement of Act 74, Mich. P.A. 1970

MARQUETTE COUNTY  
MICHIGAN  
RECEIVED FOR RECORD  
1994 DEC 29 PM 1:55

For corners in **COMMISSION**


<u>Marquette</u> <small>(County)</small>	Located In:	Corner Code #	
1. Public Land Survey	T <u>46N</u> R <u>25W</u>	I-7	
	T _____ R _____		
	T _____ R _____		
	T _____ R _____		
2. Property Controlling in Section	S _____ T _____ R _____		
	S _____ T _____ R _____		
3. Miscellaneous Property in Sec.	S _____ T _____ R _____		
	S _____ T _____ R _____		
4. Lot No. _____, Recorded Plat _____			
5. Private Claims _____			

*Patricia A. Mowbray*  
REGISTER OF DEEDS

**RATIFIED BY PEER GROUP**  
**P.A. 345 OF 1990**  
*Larry J. Busarne*  
DATE Sept 19, 1994

LIBER **1** PAGE **217**  
Register of Deeds Stamp & File Number

Michael Mileski, in a field survey on September 19 94, do hereby certify that under requirements of P.A. 74, Michigan P.A. of 1970, the corner points mentioned in lines 1 and 2 above were in conformance with regulations and rules therefore as required in the current manual of survey instructions of the United States Department of the Interior, Bureau of Land Management or by a decree of a Court of Law and/or that the corner points mentioned in lines 3, 4 and 5 above were in conformance with the rules of the Michigan Board of Land Surveyors or by a Decree of a Court of Law; established, re-established, monumented, re-monumented, recovered, found as expressed below:

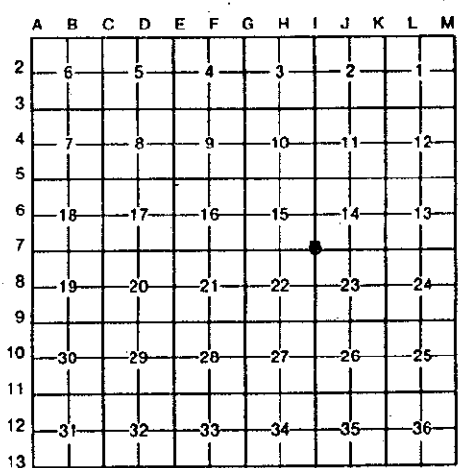

**NOTE: Not more than 4 corners, all in the same town and range, may be recorded on this certificate.**

A. Description of original monument and accessories and/or subsequent restoration:  
I-7; Northwest Corner Section 23;  
See back of form.



B. Description of corner evidence found and/or method applied in restoring or reestablishing corner:  
I-7; Northwest Corner Section 23;  
Found DNR monument as set by Paul Bressette, P.S.

State Plane Coordinates:  
Grid System - NAD 83  
Zone Number - 2111 Michigan North  
Units - International Feet  
Y = 581109.59783  
X = 26143912.98370

C. Description of monument for corner and accessories established to perpetuate locating the position of the corner:  
I-7; Northwest Corner Section 23;  
Replaced found DNR monument with 2" I.D. x 30' aluminum pipe with 3" aluminum cap (Berntsen A1NB301) appropriately stamped as to location.

Set 60d spike	S/side	7" Jack Pine	N64°E	36.82'
Set 60d spike	NW/side	9" Jack Pine	S21°W	47.19'
Set 60d spike	S/side	13" Jack Pine	S81°W	32.54'
Set 60d spike	NE/side	11" Jack Pine	N33°W	75.39'
		Location Post	East	1.5'

Signed by *Michael Mileski* Date 21 Dec 1994  
Surveyor's Michigan License No. 39091

27# 6476  
9#  
27# Jun

A. Description of original monument and accessories and/or subsequent restoration:

I-7; Northwest Corner Section 23;

Originally established during U.S. Survey conducted by Wm. Ives, D.S. for Douglass Houghton, D.S. in 1845 and monumented with a wood post witnessed by a Spruce Pine 6 N67°E 13 lks. and a Spruce Pine 6 S62°W 33 lks.

This corner was remonumented with a 1" iron pipe and jack pine post on 6 May 1942 by the Marquette County Road Commission. Refer to M.C.R.C. field book 712 page 12.

The M.C.R.C. noted the following new bearing trees:

- 6" Jack Pine S81°W 48.9'
- 10" Jack Pine N48°E 72.7'

Per Land Corner Certificate filed by Michigan DNR surveyor Paul Bressette, P.S. and recorded Liber 5 R.C. Page 379, this corner as monumented by the M.C.R.C. was found existent on 29 June 1993. Mr. Bressette states that he recovered a 1" iron pipe in agreement with the southwest M.C.R.C. new bearing tree found alive (12" dia.) with the lower face blaze and scribing evident. Mr. Bressette replaced the 1" iron pipe with a DNR monument and noted the following new bearing trees:

- 6" Jack Pine N71°E 36.82'
- 8" Jack Pine S27°W 47.19'
- 11" Jack Pine S87°W 32.34'
- 10" Jack Pine N27°W 75.39'