

APR 01 1996

JOB NUMBER: 95033 COMMISSION SHEET NO. : 1-628

LAND CORNER RECORDATION CERTIFICATE Filing Requirement of Act 74, Mich. P.A. 1970

For corners in MARQUETTE (County) Located In: Corner Code #

Table with 4 rows of survey types (Public Land Survey, Property Controlling, etc.) and columns for Town/Range (T47N, R26W, etc.) and Corner Code (M-13, A-13, M-1, A-1).

4. Lot No. , Recorded Plat Private Claims

I, GERALD W. CARLSON, in a field survey on Monday, November 27, 1995, do hereby certify that under requirements of P.A. 74, Michigan P.A. of 1970, the corner points mentioned in lines 1 and 2 above were in conformance with regulations and rules therefore as required in the current manual of survey instructions of the United States Department of the Interior, Bureau of Land Management or by a decree of a Court of Law and/or that the corner points mentioned in lines 3, 4 and 5 above were in conformance with the rules of the Michigan Board of Professional Surveyors or by a Decree of a Court of Law; established, re-established, monumented, re-monumented, recovered, found as expressed below:

NOTE: Not more than 4 corners, all in the same town and range, may be recorded on this certificate.

A. Description of original monument and accessories and/or subsequent restoration:

M-13: Section Corner common to Section 36, T47N-R26W Section 31, T47N-R25W; Section 1, T46N-R26W; and Section 6, T46N-R25W. 1844: William A. Burt's original survey notes describe the corner monument as a wood post without references.

B. Description of corner evidence found and/or method applied in restoring or reestablishing corner:

1995: Found and rejected a 3/4" diameter rod with a 1 1/4" square top, 4" above ground. Distance North is 2643.14', and Distance South is 5303.79'. The East-West position of this found iron checks well with existing irons. The North-South position does not fit the position of the D.N.R. corners 1 mile North and 1 mile South. The measured 2 mile distance from the S.E. Corner of Section 1, T46N-R26W to the N.E. Corner of Section 36, T47N-R26W, was 1.94' less than the D.N.R. in 1951. The corner was set at the proportional distance between the found corners 1 mile North and 1 mile South on line between the found 3/4" diameter rod and the found corner 1 mile North, 22.68' North of the found 3/4" diameter rod.

RATIFIED BY PEER GROUP P.A. 845 OF 1990

Signature: Larry J. Bussone DATE 11/13/95

C. Description of monument for corner and accessories established to perpetuate locating the position of the corner:

1995: Set a 2 3/8" O.D. aluminum pipe capped with a 3 1/4" diameter aluminum tablet Marquette County Survey Monument, flush with ground, and stamped to identify the corner. Referenced by double headed nails set in:

- 7" J. Pine N11W, 38.63'
7" J. Pine N67E, 38.93'
7" J. Pine S30W, 41.19'
7" J. Pine S66E, 29.60'
Green Steel Sign Post w/Yellow Survey Marker Sign West, 1.0'

Note: Found 3/4" bar was driven below ground on 11/27/95. Bearing trees all were face and butt blazed, painted, and had Bearing Tree Tags affixed.


Bk. 9. pp. 65-66.

Signed by Gerald W. Carlson

Date 12-15-95

Surveyor's Michigan License No. 24589

FORM APPROVED BY MICHIGAN STATE BOARD OF PROFESSIONAL SURVEYORS

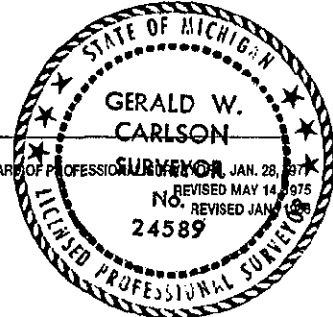

Vertical stamp: MARQUETTE COUNTY MICHIGAN RECEIVED FOR RECORD 1995 DEC 27 AM 7:45 REGISTER OF DEEDS

LIBER 1 PAGE 24 Register of Deeds Stamp & File Number

Grid table with columns A-L and rows 2-13, containing numbers 1-36.