

1999 DEC 22 AM 11:24

Patricia A. Mosley
REGISTER OF DEEDS

SECTION

LAND CORNER RECORDATION CERTIFICATE
Filing Requirement of Act 74, Mich. P.A. 1970

For corners in MARQUETTE Located In: Corner Code #
(County)

1. Public Land Survey T 46N R 25W A-3
T 46N R 26W M-3 ✓
T _____ R _____
T _____ R _____

2. Property Controlling S _____ T _____ R _____
in Section S _____ T _____ R _____

3. Miscellaneous S _____ T _____ R _____
Property in Sec. S _____ T _____ R _____

4. Lot No. _____, Recorded Plat _____

5. Private Claims _____

LIBER **R2** PAGE 195

Register of Deeds Stamp & File Number

I, GERALD W. CARLSON, in a field survey on May 12, 19 99, do hereby state that under requirements of P.A. 74, Michigan P.A. of 1970, the corner points mentioned in lines 1 and 2 above were in conformance with regulations and rules therefore as required in the current manual of survey instructions of the United States Department of the Interior, Bureau of Land Management or by a decree of a Court of Law and/or that the corner points mentioned in lines 3, 4 and 5 above were in conformance with the rules of the Michigan Board of Land Surveyors or by a Decree of a Court of Law; established, re-established, monumented, recovered, found as expressed below:

NOTE: Not more than 2 corners, all in the same town and range, may be recorded on this certificate.

A. Description of original monument and accessories and/or subsequent restoration:
A-3: Corner common to Sections 6 and 7, T46N-R25W and Sections 1 and 12, T46N-R26W.

1844: William A. Burt's original township boundary survey notes describe the corner monument as a wood post referenced by:
4" S. Pine N60E, 6L 4" S. Pine S33W, 30L

1845: William Ives' original subdivision survey notes of T46N-R25W do not describe the corner. He adds the following references:
12" White Pine N72E, 9L 18" White Pine S18E, 16L

1951: A Land Corner Record by Dean Delameter, P.S. # 5778 of the Michigan Department of Conservation, indicates he set a 1" pipe with a 4" brass cap. He states: "This corner was established, by Forestry division survey crew while making a partial resurvey of this area. Burned over plains, no original evidence available. Corner was placed and witnessed September 4, 1951." Referenced by:
10" Jack Pine N63W, 53L 8" Jack Pine N22E, 91L

No Date: Cleveland Cliffs coordinate data sheets, indicate the corner is distance N01-06-15E, 5281.19' to the township corner and S00-24-59W, 2636.16' to the West 1/4 corner of Section 7, T45N-R25W. No monument description or references given.

No Date: Marquette County Road Commission notes indicate the corner is a 1" iron pipe with 4" brass cap with the following references:

10" Jack Pine N63W, 53L 8" Jack Pine N22E, 91L

B. Description of corner evidence found and/or method applied in restoring or reestablishing corner:

A-3: 1999: No original corner evidence found. Found and accepted a 1 1/4" outside diameter pipe with a 4" brass tablet projecting 1.4' above ground and stamped for identification. Distance North is 2640.03', South is 2636.02'.

C. Description of monument for corner and accessories established to perpetuate locating the position of the corner:

A-3: 1999: We stamped the 1 1/4" outside diameter pipe with a 4" brass tablet monument with "MCR 1999" and drove it into the ground so it now projects 0.85' above ground and is stable. Measured found references:

12" Jack Pine S03W, 45.30' 8" Jack Pine N69W, 12.35'

7" Jack Pine N07W, 15.60'

Established new reference:

9" Jack Pine S71E, 79.92'

Green Steel Sign Post w/ Yellow Survey Marker Sign S82W, 1.55'


Note: Bearing trees have painted face, butt, and side nail blazes, d.h. measuring nails, and stamped B.T. Tags affixed.

T46N-R25W Corner Search Sheet 99100

1	A	B	C	D	E	F	G	H	I	J	K	L	M
2		6		5		4		3		2		1	
3													
4		7		8		9		10		11		12	
5													
6		18		17		16		15		14		13	
7													
8		19		20		21		22		23		24	
9													
10		30		29		28		27		26		25	
11													
12		31		32		33		34		35		36	
13													

RATIFIED BY PEER GROUP
P.A. 345 OF 1990

Larry J. Brossone
DATE 10/25/99

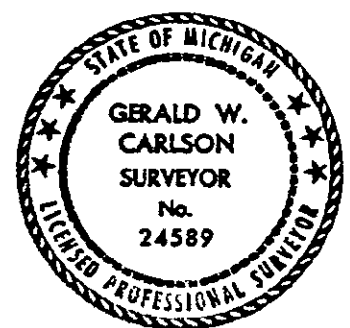

Signed by Gerald W. Carlson

Date 12-8-99

Surveyor's Michigan License No. 24589