

1999 DEC 22 AM 11:24

Patricia A. Monley REGISTER OF DEEDS

SECTION

LAND CORNER RECORDATION CERTIFICATE Filing Requirement of Act 74, Mich. P.A. 1970

For corners in MARQUETTE (County) Located In: Corner Code # 1. Public Land Survey T 46N R 25W A-7 T 46N R 26W M-7 2. Property Controlling in Section S T R 3. Miscellaneous Property in Sec. S T R 4. Lot No. , Recorded Plat 5. Private Claims

LIBER R2 PAGE 199

Register of Deeds Stamp & File Number

I, GERALD W. CARLSON, in a field survey on May 14, 1999, do hereby state that under requirements of P.A. 74, Michigan P.A. of 1970, the corner points mentioned in lines 1 and 2 above were in conformance with regulations and rules therefore as required in the current manual of survey instructions of the United States Department of the Interior, Bureau of Land Management or by a decree of a Court of Law and/or that the corner points mentioned in lines 3, 4 and 5 above were in conformance with the rules of the Michigan Board of Land Surveyors or by a Decree of a Court of Law; established, re-established, monumented, recovered, found as expressed below:

NOTE: Not more than 2 corners, all in the same town and range, may be recorded on this certificate.

A. Description of original monument and accessories and/or subsequent restoration: A-7: Corner common to Sections 18 and 19, T46N-R25W and Sections 13 and 24, T46N-R26W.

1844: William A. Burt's original township boundary survey notes describe the corner monument as a wood post referenced by: 30" W. Pine N58E, 20L 10" Fir N50W, 20L

1845: William Ives' original subdivision survey notes of T46N-R25W do not describe the corner. He adds the following references: 10" Fir S76E, 12L 7" Maple N48E, 06L

1953: A Land Corner Record by the Michigan Department of Conservation, indicates they set a 1" pipe with a 4" brass cap. The Land Corner Record states: "This corner was found by Forestry Division survey crew, while making a partial resurvey of this area. One original B.T. still in place, in poor condition. Corner was placed and witnessed November 10, 1953." The following references were given: 9" W. Pine S60W, 17L 6" Spruce N70E, 5L

(SEE REVERSE SIDE)

B. Description of corner evidence found and/or method applied in restoring or reestablishing corner:

A-7: 1999: No original corner evidence found. Found and accepted a 1 1/4" outside diameter iron pipe with 4" diameter brass tablet projecting 1.4' above ground.

Found 10" Stump (Dept. of Conservation NBT) S65W, 11.8' to centerline

Checked Line Call: North, 19.3 chains(1273.8'), intersected East branch of Escanaba River. With a hip chain we measured 1305' to the river. Distance North is 2625.62', South is 2634.88'.

C. Description of monument for corner and accessories established to perpetuate locating the position of the corner:

A-7: 1999: Stamped the 1 1/4" outside diameter iron pipe with 4" diameter brass tablet monument with: "MCR 1999". Monument is 1.4' above ground.

Established new references:

11" Spruce N21W, 32.99' 9" Spruce N61W, 28.55'

Measured existing references:

21" W. Pine N78W, 46.04' (SCA-1990) 11" W. Birch S28W, 29.98' (SCA-1990)


Green Steel Sign Post w/ Yellow Survey Marker Sign N64W, 3.0'

Note: Bearing trees have painted face, butt, and side nail blazes, d.h. measuring nails, and stamped B.T. Tags aff. T46N-R25W Corner Search Report 99100

Grid table with columns A-LM and rows 1-12. Cell (7, A) contains a black dot.

RATIFIED BY PEER GROUP P.A. 345 OF 1990

Larry J. Bussone DATE 10/25/99

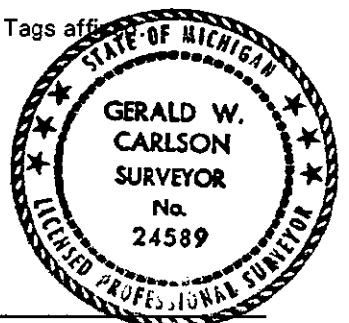

Signed by Gerald W. Carlson

Date 12-8-99

Surveyor's Michigan License No. 24589

A-7:

PART A CONTINUED:

1990: A survey calculation sheet by Gerry Carlson, P.S. #24589, indicates the corner distance S88-58-30E, 5155.34' to a DNR monument at the section corner common to Sections 16, 17, 20, and 21. No references were given. The monument is described as a DNR.

1990: An easement description map by Sundberg, Carlson and Associates, Inc. for Wisconsin Electric, indicates the corner location distance 1209.92' to the West 1/16 line along the South section line and 2525.06' to the North-South 1/4 line along the South section line. No description or references were given.

1990: Survey field notes by Sundberg, Carlson and Associates, Inc., indicate a found 1 1/4" iron pipe with aluminum cap with the following established references:

16" W. Pine	N77W,	46.04'	7" W. Birch	NOE,	17.50'
8" W. Birch	N72E,	5.47'	10" W. Birch	S28W,	29.95'

1991: A survey calculation sheet by Gerry Carlson, P.S. #24589, indicates the corner distance S00-08-08W, 5269.68' to the section corner common to Sections 19 and 30, T46N-R25W and Sections 24 and 25, T46N-R26W. No references or description were given.

1990: A survey calculation sheet by Gerry Carlson, P.S. #24589, indicates the corner distance S00-28-32E, 5269.45' to the section corner common to Sections 19 and 30, T46N-R25W and Sections 24 and 25, T46N-R26W. No references or description were given.

1990-1991
SECTION